

STATE ENGINEER
Salem, Oregon

WASH

Well Record

008980

STATE WELL NO. 1/LW-21K
COUNTY Washington
APPLICATION NO. CR-3837

OWNER: Robert M. Stewart

MAILING
ADDRESS:

Route 1, Box 44

LOCATION OF WELL: Owner's No.


CITY AND
STATE:

Beaverton, Oregon

NW 1/4 SE 1/4 Sec. 21 T. 1 S. R. 1 W., W.M.

Bearing and distance from section or subdivision

corner about 2460' N. & 1950' W. from SE Cor. Sec. 21

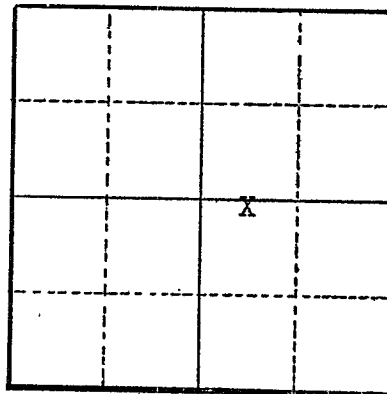

Section 21

Altitude at well

TYPE OF WELL: Drilled Date Constructed Oct., 1951

Depth drilled 140 feet Depth cased

CASING RECORD:

6 inch casing set from Elev. 270 to Elev. 160

FINISH:

AQUIFERS:

WATER LEVEL:

85 feet below surface

PUMPING EQUIPMENT: Type Pacific Berford 7 stage H.P. 2
Capacity 42 G.P.M.

WELL TESTS:

Drawdown 1 1/2 ft. after 42 hours G.P.M.

Drawdown ft. after hours G.P.M.

USE OF WATER Irrigation Temp. °F. 19

SOURCE OF INFORMATION Well Registration Statement

DRILLER or DIGGER Carsh Bros.

ADDITIONAL DATA:

Log Water Level Measurements Chemical Analysis Aquifer Test

REMARKS: