

STATE ENGINEER
Salem, Oregon

WASH Well Record

STATE WELL NO. 111W-21P(1)
COUNTY Washington
APPLICATION NO. GR-343

008988

OWNER: City of Beaverton


MAILING ADDRESS: City Hall

LOCATION OF WELL: Owner's No. #2

CITY AND STATE: Beaverton, Oregon

SE $\frac{1}{4}$ SW $\frac{1}{4}$ Sec. 21 T. 1 S., R. 1 W., W.M.

Bearing and distance from section or subdivision corner 2500 feet east and 460 feet north from the SW corner of section 21,

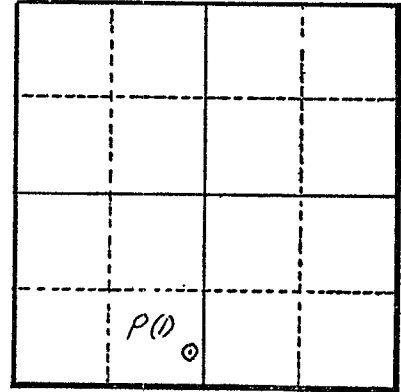

Section 21

Altitude at well 350 feet Interpolated

TYPE OF WELL: Drilled Date Constructed 1945

Depth drilled 800 Depth cased 800

CASING RECORD:

- 16 — inch casing set from 0 to 63 feet.
- 15 — " " " " 63 to 450 feet.
- 12 — " " " " 450 to 800 feet.

FINISH:

none ?

AQUIFERS:

rock from 90 to 800 feet.

WATER LEVEL:

170 feet below land surface. Dec. 1945.

PUMPING EQUIPMENT: Type Fairbanks-Morse Turbine H.P. 60
Capacity 950 G.P.M.

WELL TESTS:

Drawdown 80 ft. after _____ hours pumping? G.P.M.
Drawdown _____ ft. after _____ hours _____ G.P.M.

USE OF WATER Municipal 950 gpm ^{2 cfs.} Temp. _____ °F., 19 _____

SOURCE OF INFORMATION Reg. Statement GR-343

DRILLER or DIGGER -

ADDITIONAL DATA:

Log yes Water Level Measurements _____ Chemical Analysis X Aquifer Test _____

REMARKS:

