

STATE ENGINEER  
Salem, Oregon

WASH

# Well Record

STATE WELL NO. 1/1W-23P  
COUNTY Washington  
APPLICATION NO. GR-4157

009010

OWNER: Fred L. Abbott


MAILING ADDRESS: 7970 S.W. Scholls Ferry Rd.

LOCATION OF WELL: Owner's No. \_\_\_\_\_

CITY AND STATE: Beaverton, Oregon

SE 1/4 SW 1/4 Sec. 23 T. 1 S., R. 1 W., W.M.

Bearing and distance from section or subdivision  
corner 800' W. & 75' N. from St. Cor. Sec. 23

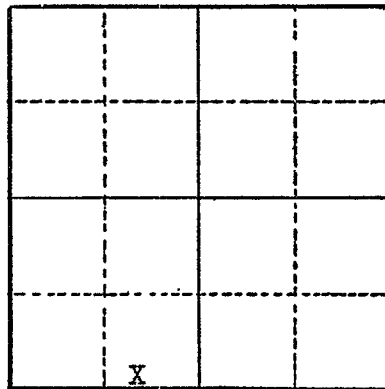

Section 23

Altitude at well \_\_\_\_\_

TYPE OF WELL: Drilled Date Constructed 8/1/51

Depth drilled 206 ft. Depth cased 206 ft.

### CASING RECORD:

- 8 in. casing set to 186 ft.
- 6 in. casing from 186 to 206 ft.

### FINISH:

Perforated casings 6 in. from 186 to 206 feet

### AQUIFERS:

### WATER LEVEL:

PUMPING EQUIPMENT: Type Cook H.P. 1  
Capacity 5 G.P.M.

### WELL TESTS:

Drawdown \_\_\_\_\_ ft. after \_\_\_\_\_ hours \_\_\_\_\_ G.P.M.  
 Drawdown \_\_\_\_\_ ft. after \_\_\_\_\_ hours \_\_\_\_\_ G.P.M.

USE OF WATER Irrigation Temp. \_\_\_\_\_ °F. \_\_\_\_\_, 19

SOURCE OF INFORMATION Well Registration Statement Cert. # GR-3724

DRILLER or DIGGER L. W. Strater

### ADDITIONAL DATA:

Log \_\_\_\_\_ Water Level Measurements \_\_\_\_\_ Chemical Analysis \_\_\_\_\_ Aquifer Test \_\_\_\_\_

### REMARKS: