

STATE ENGINEER  
Salem, Oregon

WASH  
009025

# Well Record

STATE WELL NO. 111W-24D  
COUNTY WASHINGTON  
APPLICATION NO. GR-2104

OWNER: PORTLAND Golf Club  
GEORGE B. North, Mgr.


MAILING ADDRESS: 5900 S. W. Scholls Ferry Rd.

LOCATION OF WELL: Owner's No. #2

CITY AND STATE: Portland, OREGON

NW 1/4 NW 1/4 Sec. 24 T. 1 N. S. R. 1 E. W., W.M.

Bearing and distance from section or subdivision corner S42°DE 1280'

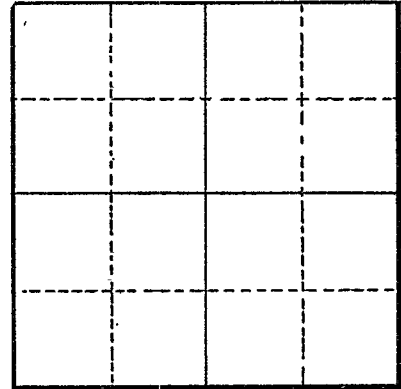

Section .....

Altitude at well .....

TYPE OF WELL: Drilled Date Constructed 1923

Depth drilled 400 Depth cased 400

### CASING RECORD:

8-Inch

### FINISH:

120' of screens

### AQUIFERS:

### WATER LEVEL:

20-Foot

PUMPING EQUIPMENT: Type Air lift Piston H.P. 15  
Capacity 500 G.P.M.

### WELL TESTS:

Drawdown 90' ft. after ..... hours Pumping 500 G.P.M.  
Drawdown ..... ft. after ..... hours ..... G.P.M.

USE OF WATER Irrigation Temp. ..... °F. ...., 19.....

SOURCE OF INFORMATION GR-2022

DRILLER or DIGGER .....

### ADDITIONAL DATA:

Log ..... Water Level Measurements ..... Chemical Analysis ..... Aquifer Test .....

### REMARKS: