

STATE ENGINEER
Salem, Oregon

WASH
009026

Well Record


STATE WELL NO. 11W-24D
COUNTY WASHINGTON
APPLICATION NO. GR-2103

OWNER: PORTLAND GOLF CLUB
GEORGE B. North Mgr.
LOCATION OF WELL: Owner's No. #3

MAILING ADDRESS: 5900 S.W. Scholls Ferry Rd.
CITY AND STATE: PORTLAND, OREGON

Nw 1/4 Nw 1/4 Sec. 24 T. 1 N. S. R. 1 E. W. W.M.

Bearing and distance from section or subdivision corner S 39° 0' E 1260'

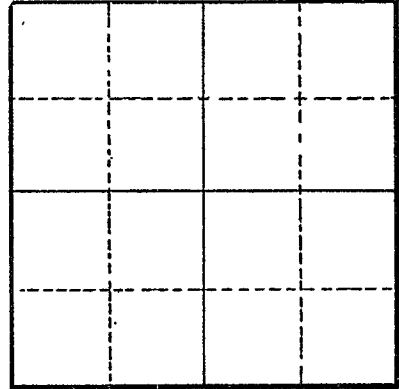

Section

Altitude at well

TYPE OF WELL: Drilled Date Constructed 1948

Depth drilled 550 Depth cased 500

CASING RECORD:

14-Inch

FINISH:

AQUIFERS:

WATER LEVEL:

26 - Feet

PUMPING EQUIPMENT: Type LAYNE AND BOWLER TURBINE H.P. 125
Capacity 1000 G.P.M.

WELL TESTS:

Drawdown 67' ft. after Pumping 1000 G.P.M.
Drawdown ft. after hours G.P.M.

USE OF WATER Irrigation Temp. °F., 19

SOURCE OF INFORMATION GR-2021

DRILLER or DIGGER SANSEN, Reedville, OREGON

ADDITIONAL DATA:

Log Water Level Measurements Chemical Analysis Aquifer Test

REMARKS: