

STATE ENGINEER
Salem, Oregon

WASH

Well Record

STATE WELL NO. 1/1W.24F
COUNTY Washington
APPLICATION NO. GR-1393

009030

GR-1363

OWNER: AARON M. FRANK

MAILING ADDRESS:


LOCATION OF WELL: Owner's No. #1

CITY AND STATE:

Garden Home, Oregon

SE 1/4 NW 1/4 Sec. 24 T. 1 S. R. 1 W., W.M.

Bearing and distance from section or subdivision corner 250' S. & 2070' W. to W 1/4 cor. Sec. 24

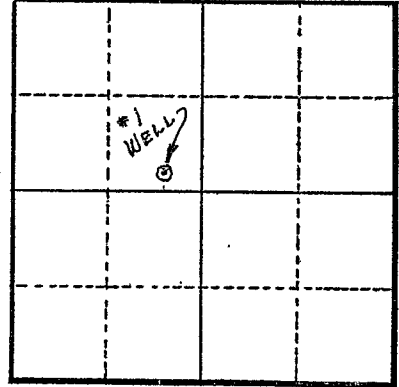

Section 24

Altitude at well 270'

TYPE OF WELL: Drilled Date Constructed 1927

Depth drilled 521' Depth cased 403'

CASING RECORD:

8"

FINISH:

AQUIFERS:

WATER LEVEL:

48'

PUMPING EQUIPMENT: Type Byron Jackson Deep Well Turbine H.P. 25
Capacity 160 G.P.M.

WELL TESTS:

Drawdown	3	ft. after	hours	160	G.P.M.
Drawdown	5	ft. after	hours	380	G.P.M.

USE OF WATER Irrigation Temp. °F. 19

SOURCE OF INFORMATION GR Record

DRILLER or DIGGER

ADDITIONAL DATA:

Log Water Level Measurements Chemical Analysis Aquifer Test

REMARKS:

Log:	Clay	0 to 403 ft.
	Solid rock	403 to 433 ft.
	Broken rock	433 to 447 ft.
	Solid rock	447 to 471 ft.
	Broken up rock	471 to 503 ft.
	Solid rock	503 to 521 ft.

Irrigation of 12 acres.