

STATE ENGINEER  
Salem, Oregon

WASH  
009037

Well Record

STATE WELL NO. 11w-25 MPD  
COUNTY Washington  
APPLICATION NO. GR-27


OWNER: Warren Forsyth

MAILING ADDRESS: 8101 SW Ceder Crest Dr.

LOCATION OF WELL: Owner's No. #1

CITY AND STATE: Portland, Oregon

NW  $\frac{1}{4}$  SW  $\frac{1}{4}$  Sec. 25 T. 1 S., R. 1 W., W.M.

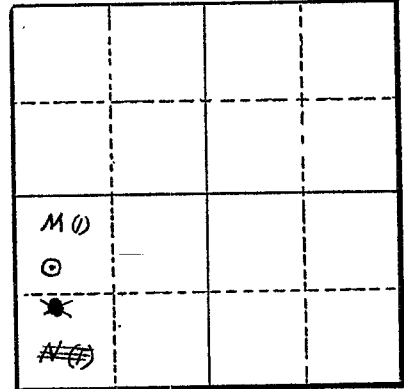

Bearing and distance from section or subdivision corner 1700 feet north and 900 feet east of SW corner of section 25 - T.1S, R.1W.

Altitude at well 85 feet Interpolated

TYPE OF WELL: Drilled Date Constructed April 1949

Depth drilled 240' Depth cased 135'

CASING RECORD:

6-inch casing set from 0' to 135 feet.

FINISH:

None - cemented casing to rock at 135 feet.

AQUIFERS:

Basalt, from 236' to 240 feet

WATER LEVEL:

16 feet below land surface, April 1949

PUMPING EQUIPMENT: Type Peerless #42 High lift (at 135) H.P. 3  
Capacity 30 G.P.M.

WELL TESTS:

Drawdown 110 ft. after 30 hours G.P.M.  
Drawdown 180 ft. after 50 hours G.P.M.

USE OF WATER Irrigation 6 acres Temp.          °F., 19         

SOURCE OF INFORMATION Registration Statement GR-27

DRILLER or DIGGER John W. Beck, Canby, Oregon

ADDITIONAL DATA:

Log  Water Level Measurements  Chemical Analysis  Aquifer Test

REMARKS:

