

STATE ENGINEER  
Salem, Oregon

WASH  
009054

Well Record

STATE WELL NO. HW-27 H10  
COUNTY Wash.  
APPLICATION NO. GP-553

OWNER: Sawyer's Inc.


MAILING ADDRESS: P.O. Box 490

LOCATION OF WELL: Owner's No. \_\_\_\_\_

CITY AND STATE: Portland 7, Ore

SE 1/4 NE 1/4 Sec. 27 T. 1 S., R. 1 W., W.M.

Bearing and distance from section or subdivision corner 599 ft. N. 28° 30' W. of 1/4 cor. sec 27

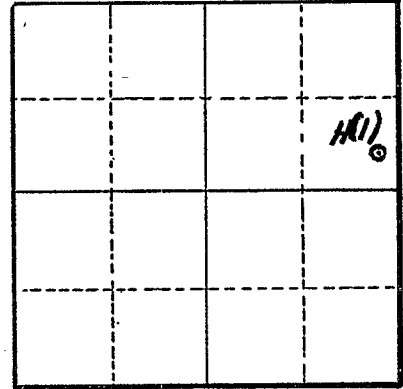

Section 27

Altitude at well 209

TYPE OF WELL: drilled Date Constructed 1950

Depth drilled 160 Depth cased ?

CASING RECORD:  
12 inch

FINISH:

AQUIFERS:

WATER LEVEL:

32

PUMPING EQUIPMENT: Type Peerless H.P. 15  
Capacity 200 G.P.M.

WELL TESTS:

Drawdown 32 ft. after \_\_\_\_\_ hours 20 G.P.M.  
Drawdown \_\_\_\_\_ ft. after \_\_\_\_\_ hours \_\_\_\_\_ G.P.M.

USE OF WATER industrial Temp. \_\_\_\_\_ °F. \_\_\_\_\_, 19\_\_\_\_\_

SOURCE OF INFORMATION GP-553

DRILLER or DIGGER Strayer; Beaverton, Ore

ADDITIONAL DATA:

Log \_\_\_\_\_ Water Level Measurements \_\_\_\_\_ Chemical Analysis \_\_\_\_\_ Aquifer Test \_\_\_\_\_

REMARKS: