

STATE ENGINEER
Salem, Oregon

WASH

Well Record

STATE WELL NO. 1W-28 (R)
COUNTY Washington
APPLICATION NO. GR-894


009076

OWNER: Armand John De Rosset Jr MAILING ADDRESS: RFL Box 305 D

LOCATION OF WELL: Owner's No. CITY AND STATE: Beaverton

SW 1/4 ~~NE~~ SE 1/4 Sec. 28 T. 1 S, R. 1 W, W.M.

Bearing and distance from section or subdivision corner 1250' N & 1200' E of 1/4 Cor on South line of Sec 28

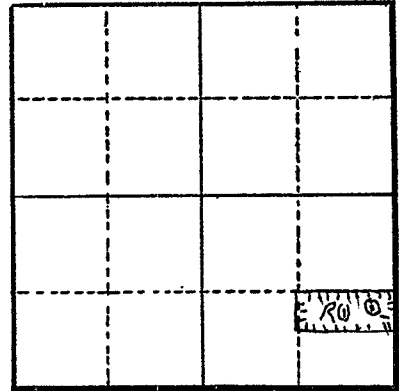

Section 28

Altitude at well 230

TYPE OF WELL: drilled Date Constructed 1948 (EST)

Depth drilled 360 + Depth cased 411 K

CASING RECORD:

6" casing

FINISH:

AQUIFERS:

WATER LEVEL:

88'

PUMPING EQUIPMENT: Type Red Jacket Submersible H.P. 5/8
Capacity 325 G.P.M.

WELL TESTS:

Drawdown _____ ft. after _____ hours _____ G.P.M.
Drawdown _____ ft. after _____ hours _____ G.P.M.

USE OF WATER Irrigation Temp. _____ °F. _____, 19_____

SOURCE OF INFORMATION Owner

DRILLER or DIGGER Zimmerman - has since left territory

ADDITIONAL DATA:

Log NA Water Level Measurements _____ Chemical Analysis _____ Aquifer Test _____

REMARKS:

Submersible Pump set at 125'