

STATE ENGINEER
Salem, Oregon

WASH


Well Record

STATE WELL NO. 1/IW-30B
COUNTY Washington
APPLICATION NO. GR-3812

009137

OWNER: Glen Brisbane
MAILING ADDRESS: Route 1, Box 1152
CITY AND STATE: Beaverton, Oregon

LOCATION OF WELL: Owner's No. NW 1/4 NE 1/4 Sec. 30 T. 1 S., R. 1 W., W.M.
Bearing and distance from section or subdivision corner About 2360' W. & 570' S. from NW Cor. of Sec. 30

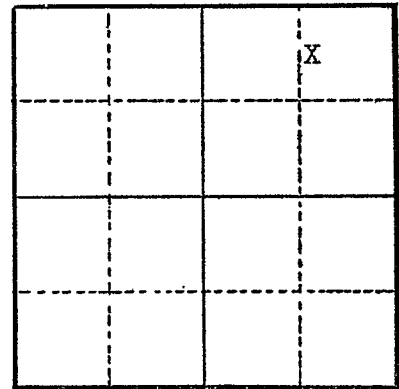

Section 30

Altitude at well

TYPE OF WELL: Drilled Date Constructed Aug., 1949

Depth drilled 270 feet Depth cased 70 feet

CASING RECORD:

6 inch steel casing set to 70 feet

FINISH:

AQUIFERS:

WATER LEVEL:

160 feet below surface

PUMPING EQUIPMENT: Type Goulds 6 inch working head H.P. 1
Capacity 5 G.P.M.

WELL TESTS:

Drawdown 0 ft. after 2 hours G.P.M.
Drawdown ft. after hours G.P.M.

USE OF WATER Irrigation Temp. °F., 19

SOURCE OF INFORMATION Well Registration Statement

DRILLER or DIGGER

ADDITIONAL DATA:

Log X Water Level Measurements Chemical Analysis Aquifer Test

REMARKS:

Log: Clay Thickness 70
Rock 200