

STATE ENGINEER  
Salem, Oregon

WASH  
009154

Well-Record

STATE WELL NO. 1/1W-30H  
COUNTY ~~MULTNOMAH~~ WASHINGTON  
APPLICATION NO. GR-3271

OWNER: C. V. Morrison


MAILING ADDRESS: 922 SW 17th Ave.

LOCATION OF WELL: Owner's No.

CITY AND STATE: Portland, Oregon

SE 1/4 NE 1/4 Sec. 30 T. 1 S., R. 1 W., W.M.

Bearing and distance from section or subdivision  
corner 200' SE of NW cor of SE 1/4 NE 1/4

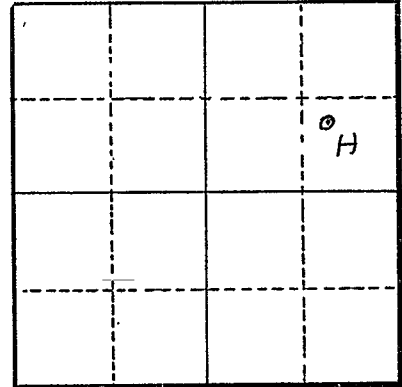

Section 30

Altitude at well

TYPE OF WELL: Drilled Date Constructed 1950

Depth drilled 305' Depth cased 41' 8"

CASING RECORD:

6-inch

FINISH:

AQUIFERS:

solid rock

WATER LEVEL:

230'

PUMPING EQUIPMENT: Type Beresford Submersible

H.P. 2

Capacity 12-15 G.P.M.

WELL TESTS:

Drawdown 40 ft. after 10 hours G.P.M.

Drawdown ft. after hours G.P.M.

USE OF WATER Irrigation Temp. °F. 19

SOURCE OF INFORMATION GR-3919

DRILLER or DIGGER L. W. Strayer

ADDITIONAL DATA:

Log NA Water Level Measurements Chemical Analysis Aquifer Test

REMARKS:

Solid rock was encountered at about 40'