

STATE ENGINEER
Salem, Oregon

WASH

Well Record

STATE WELL NO. 1/1W-31L
COUNTY Washington
APPLICATION NO. GR-4053


009160

OWNER: Lester Arnold Montgomery MAILING ADDRESS: Route 1, Box 484

LOCATION OF WELL: Owner's No. CITY AND STATE: Beaverton, Oregon

NW 1/4 SW 1/4 Sec. 31 T. 1 S., R. 1 W., W.M.

Bearing and distance from section or subdivision corner 1200' S. & 950' W. of center

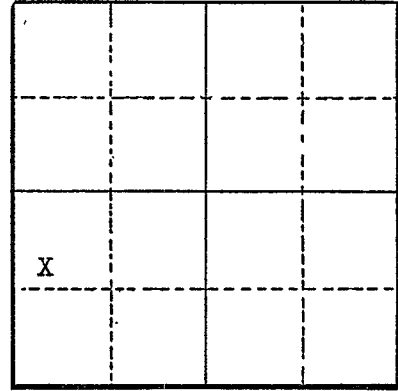

Section 31

Altitude at well

TYPE OF WELL: Drilled Date Constructed 3/1/50

Depth drilled 433 ft. Depth cased 9 ft.

CASING RECORD:

6 inch well casing set to 9 feet.
Rest of well drilled thru solid rock.

FINISH:

AQUIFERS:

WATER LEVEL:

PUMPING EQUIPMENT: Type Myers piston H.P. 3/4
Capacity G.P.M.

WELL TESTS:

Drawdown ft. after hours G.P.M.
Drawdown ft. after hours G.P.M.

USE OF WATER Irrigation Temp. °F., 19

SOURCE OF INFORMATION Well Registration Statement Cert. # GR-3653

DRILLER or DIGGER Janssen Drilling Company

ADDITIONAL DATA:

Log X Water Level Measurements Chemical Analysis Aquifer Test

REMARKS:

