

STATE ENGINEER
Salem, Oregon

WASH
009220

Well Record

STATE WELL NO. 1/1W-34A
COUNTY WASHINGTON
APPLICATION NO. GR-3534

OWNER: William R. Robinson


MAILING ADDRESS: 10315 SW Scholls Ferry Rd

LOCATION OF WELL: Owner's No.

CITY AND STATE: Tigard, Oregon

NE 1/4 NE 1/4 Sec. 34 T. 1 S., R. 1 W., W.M.

Bearing and distance from section or subdivision corner 950' W & 510' S From NE cor Sec 34

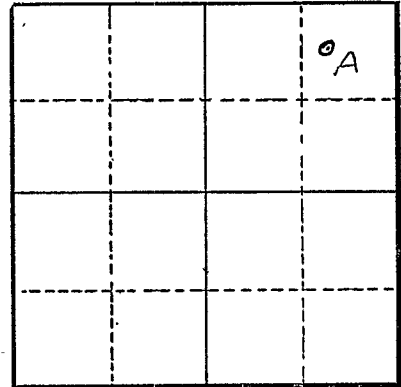

Altitude at well

TYPE OF WELL: Drilled Date Constructed 1953

Depth drilled 80' Depth cased 75'

Section 34

CASING RECORD:

12-inch

FINISH:

AQUIFERS:

WATER LEVEL:

PUMPING EQUIPMENT: Type H.P. 10
Capacity 300 G.P.M.

WELL TESTS:

Drawdown ft. after hours G.P.M.
Drawdown ft. after hours G.P.M.

USE OF WATER Irrigation Temp. °F., 19

SOURCE OF INFORMATION GR-3959

DRILLER or DIGGER L. Strayer

ADDITIONAL DATA:

Log Water Level Measurements Chemical Analysis Aquifer Test

REMARKS:

