

STATE ENGINEER  
Salem, Oregon

WASH

Well Record

GR-1425


STATE WELL NO. 1/2W-2H  
COUNTY Washington  
APPLICATION NO. GR-1476

OWNER: A. F. Molek 009365 MAILING ADDRESS: 920 SW 206th

LOCATION OF WELL: Owner's No. CITY AND STATE: Aloha, Oregon

SE 1/4 NE 1/4 Sec. 2 T. 1 S., R. 2 W., W.M.

Bearing and distance from section or subdivision corner S.2°30'W. 2520' from NE cor. of Sec. 2

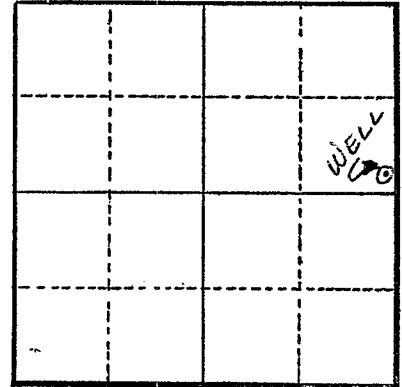

Altitude at well 150'

TYPE OF WELL: Drilled Date Constructed 1948

Depth drilled 50' Depth cased 50'

Section 2

CASING RECORD:  
8"

FINISH:

AQUIFERS:

WATER LEVEL:  
15'

PUMPING EQUIPMENT: Type Myers jet H.P. 3/4  
Capacity 13 G.P.M.

WELL TESTS:  
Drawdown 13 ft. after 13 hours G.P.M.  
Drawdown ft. after hours G.P.M.

USE OF WATER Irrigation Temp. °F., 19

SOURCE OF INFORMATION GR Record

DRILLER or DIGGER Owner

ADDITIONAL DATA:  
Log N.A. Water Level Measurements Chemical Analysis Aquifer Test

REMARKS:  
Irrigation of 2.15 acres