

STATE ENGINEER
Salem, Oregon

WASH

Well Record

STATE WELL NO. 1/2W-3D(2)
COUNTY Washington
APPLICATION NO. GR 1294

009382 ~~GR 1251~~

OWNER: Willy E. Heinrich


MAILING ADDRESS: 20225 SW Kinnamon Rd.

LOCATION OF WELL: Owner's No. #1

CITY AND STATE: Aloha, Oregon

NW 1/4 NW 1/4 Sec. 3 T. 1 S., R. 2 W., W.M.

Bearing and distance from section or subdivision corner S63°E. 850' from NW cor. Sec. 3.

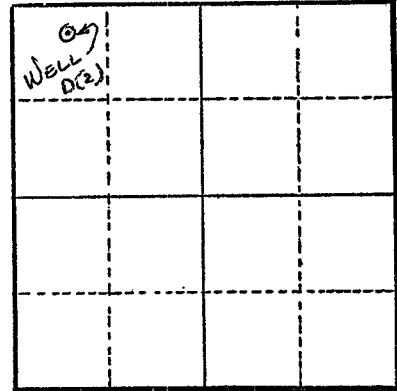

Section 3

Altitude at well 180 ft.

TYPE OF WELL: Drilled Date Constructed 1918

Depth drilled 100 ft. Depth cased 100 ft.

CASING RECORD:

6 inch

FINISH:

AQUIFERS:

WATER LEVEL:

20 ft.

PUMPING EQUIPMENT: Type Pacific jet H.P. 1
Capacity 8 G.P.M.

WELL TESTS:

Drawdown 60 ft. after 8 hours G.P.M.
Drawdown ft. after hours G.P.M.

USE OF WATER Irrigation Temp. °F. 19

SOURCE OF INFORMATION G. R. Record

DRILLER or DIGGER A. M. Jansen

ADDITIONAL DATA:

Log N.A. Water Level Measurements Chemical Analysis Aquifer Test

REMARKS:

Irrigation of 2.5 acres.