

STATE ENGINEER
Salem, Oregon

WASH Well Record

STATE WELL NO. 1/2W - 4D
COUNTY WASHINGTON
APPLICATION NO. GR-2013

009494

OWNER: Gordon Hallin

MAILING
ADDRESS:

3560 E. Main


LOCATION OF WELL: Owner's No. _____

CITY AND
STATE:

Hillsboro, Oregon

NW 1/4 NW 1/4 Sec. 4 T. 1 N.
S, R. 2 E. W., W.M.

Bearing and distance from section or subdivision
corner S 71° ' E. 1090'

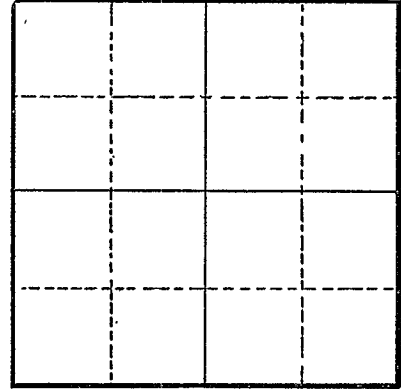

Section _____

Altitude at well _____

TYPE OF WELL: Dug Date Constructed 1930

Depth drilled 27 Depth cased 27

CASING RECORD:

4-inch

FINISH:

AQUIFERS:

WATER LEVEL:

20-feet

PUMPING EQUIPMENT: Type Centrifugal 2 1/4 H.P. 10
Capacity 50. G.P.M.

WELL TESTS:

Drawdown _____ ft. after _____ hours _____ G.P.M.
Drawdown _____ ft. after _____ hours _____ G.P.M.

USE OF WATER Irrigation Temp. _____ °F. _____, 19_____

SOURCE OF INFORMATION GR-1941

DRILLER or DIGGER Russel Ide (deceased)

ADDITIONAL DATA:

Log _____ Water Level Measurements _____ Chemical Analysis _____ Aquifer Test _____

REMARKS: