

STATE ENGINEER  
Salem, Oregon

WASH

Well Record

STATE WELL NO. 1/2W-8E  
COUNTY Washington  
APPLICATION NO. GR-972

009615

GR-1438

OWNER: Harold F. Johnson

MAILING  
ADDRESS:


LOCATION OF WELL: Owner's No.

CITY AND  
STATE:

Hillsboro, Oregon

SW 1/4 NW 1/4 Sec. 8 T. 1 S, R. 2 W., W.M.

Bearing and distance from section or subdivision  
corner 2650' S, 23°30' E, from NW cor. Sec. 8

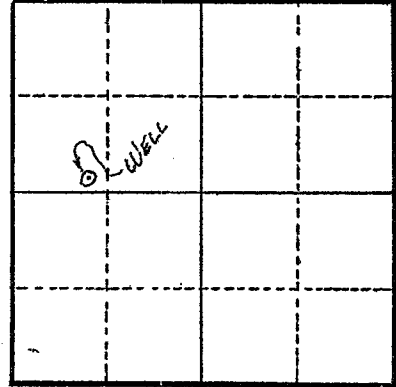

Section 8

Altitude at well 200'

TYPE OF WELL: Drilled Date Constructed 1947

Depth drilled 40' Depth cased 35'

CASING RECORD:

6" steel from 30' to 35'

FINISH:

AQUIFERS:

WATER LEVEL:

12'

PUMPING EQUIPMENT: Type Berkeley H.P. 1/2  
Capacity 15 G.P.M.

WELL TESTS:

Drawdown 30 ft. after \_\_\_\_\_ hours 20 G.P.M.  
Drawdown \_\_\_\_\_ ft. after \_\_\_\_\_ hours \_\_\_\_\_ G.P.M.

USE OF WATER Irrigation Temp. °F. 19

SOURCE OF INFORMATION GR Record

DRILLER or DIGGER Carl Millet

ADDITIONAL DATA:

Log \_\_\_\_\_ Water Level Measurements \_\_\_\_\_ Chemical Analysis \_\_\_\_\_ Aquifer Test \_\_\_\_\_

REMARKS:

Log: Top soil (Amity) 0 to 12 ft.  
Blue clay 12 to 40 ft.

Irrigation of 2.5 acres