

STATE ENGINEER
Salem, Oregon

WASH

Well Record

STATE WELL NO. 1/2W - 8B
COUNTY WASHINGTON
APPLICATION NO. GR-2144

009621

OWNER: Washington County Home

MAILING ADDRESS: 27280 S. W. Tualatin Valley Hwy.


LOCATION OF WELL: Owner's No. _____

CITY AND STATE: Hillsboro, Oregon

NW 1/4 NE 1/4 Sec. 8 T. 1 S., R. 2 W., W.M.

Bearing and distance from section or subdivision corner 1 mile east of Hillsboro, Oregon

2225' W. & 315' S.

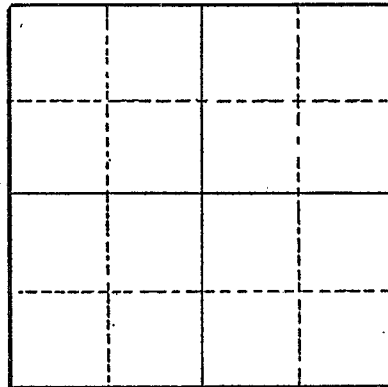

Section _____

Altitude at well _____

TYPE OF WELL: Drilled Date Constructed 1928

Depth drilled 200 Depth cased 200

CASING RECORD:

8-Inch

FINISH:

AQUIFERS:

WATER LEVEL:

35-Feet

PUMPING EQUIPMENT: Type Meyers Jet H.P. 3
Capacity 40 G.P.M.

WELL TESTS:
Drawdown 115 ft. after _____ hours Pumping 40 G.P.M.
Drawdown _____ ft. after _____ hours _____ G.P.M.

USE OF WATER Irrigation Temp. _____ °F. _____, 19____

SOURCE OF INFORMATION GR-2056

DRILLER or DIGGER A. M. Janssen, 21075 S. W. Tualatin Hwy. Aloha, Oregon

ADDITIONAL DATA:

Log _____ Water Level Measurements _____ Chemical Analysis _____ Aquifer Test _____

REMARKS: