

STATE ENGINEER
Salem, Oregon

WASH

Well Record

STATE WELL NO. 12w-950
COUNTY Wash.
APPLICATION NO. GR-442

009645

OWNER: Paul Strebek


MAILING ADDRESS: 1910 S.W. Minter Bride Rd.

LOCATION OF WELL: Owner's No. _____

CITY AND STATE: Hillsboro, Ore.

NE 1/4 NW 1/4 Sec. 8 T. 1 S., R. 2 W., W.M.

Bearing and distance from section or subdivision corner 550 ft. S. & 2330 ft. E. of the N.W. cor. sec. 8

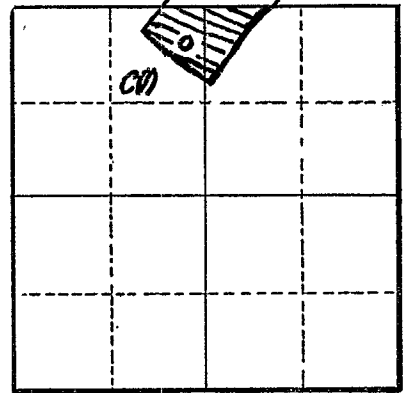

Section 8

Altitude at well 170

TYPE OF WELL: drilled Date Constructed Feb. '52

Depth drilled 55 Depth cased 55

CASING RECORD:

8 inch to 45 ft.
6 inch 45 ft to 55 ft.

FINISH:

AQUIFERS:

WATER LEVEL:

18

PUMPING EQUIPMENT: Type Berteley Jet H.P. 3
Capacity 40 G.P.M.

WELL TESTS:

Drawdown ft. after hours G.P.M.
Drawdown ft. after hours G.P.M.

USE OF WATER irrigation - 16 Ac. Temp. °F., 19.....

SOURCE OF INFORMATION GR-442

DRILLER or DIGGER Lee Barten; Hillsboro, Ore.

ADDITIONAL DATA:

Log No..... Water Level Measurements Chemical Analysis Aquifer Test

REMARKS: