

STATE ENGINEER  
Salem, Oregon

WASH

Well Record

STATE WELL NO. 1/2W-8C(1)  
COUNTY Washington  
APPLICATION NO. GR-1276

GR- 1234

009646


OWNER: Herman J. Freudenthal

MAILING ADDRESS: 2220 SW Minter Bridge Rd.

LOCATION OF WELL: Owner's No. #1

CITY AND STATE: Hillsboro, Oregon

NE 1/4 NW 1/4 Sec. 8 T. 1 S. R. 2 W., W.M.

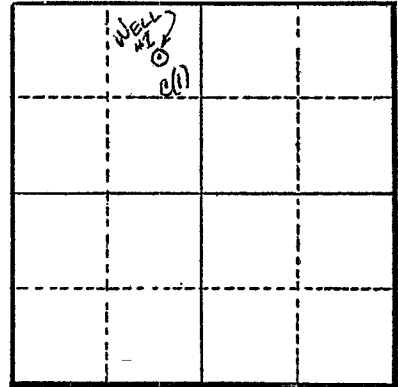

Bearing and distance from section or subdivision corner S37°W. 960' from N 1/4 cor. Sec. 8

Altitude at well

TYPE OF WELL: Drilled Date Constructed 1953

Depth drilled 123 ft. Depth cased 117 ft.

Section 8

CASING RECORD:

10 in. Steel casing from 0 to 117 ft.

FINISH:

Perforated: torch slots (2 x 1/4 in.) from 50 to 117 ft.

AQUIFERS:

WATER LEVEL:

6 ft.

PUMPING EQUIPMENT: Type Berkeley jet H.P. 3

Capacity 50 G.P.M.

WELL TESTS:

Drawdown 74 ft. after 65 hours G.P.M.

Drawdown ft. after hours G.P.M.

USE OF WATER Irrigation Temp. °F. 19

SOURCE OF INFORMATION G. R. Record

DRILLER or DIGGER Art Gaunt

ADDITIONAL DATA:

Log Water Level Measurements Chemical Analysis Aquifer Test

REMARKS:

Log: Clay & sand 0 to 15 ft.  
Sand, gray & blue 15 to 40 ft.  
Sand, blue 40 to 103 ft.  
Clay, blue 103 to 113 ft.  
Sand & small gravel 113 to 117 ft.  
Clay, blue 117 to 121 ft.  
Sand 121 to 123 ft.

Irrigation of 54.2 acres.