

STATE ENGINEER  
Salem, Oregon

WASH  
009648

# Well Record

GR-1233

STATE WELL NO. 1/2W-8C(2)  
COUNTY Washington  
APPLICATION NO. GR-1275

OWNER: Herman J. Freudenthal


MAILING ADDRESS: 2220 SW Minter Bridge Rd.

LOCATION OF WELL: Owner's No. #2

CITY AND STATE: Hillsboro, Oregon

NE 1/4 NW 1/4 Sec. 8 T. 1 S, R. 2 W., W.M.

Bearing and distance from section or subdivision corner S12°W. 1090' from N 1/4 cor. Sec. 8

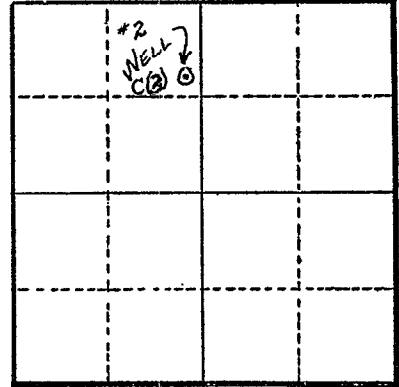

Section 8

Altitude at well

TYPE OF WELL: Drilled Date Constructed 1953

Depth drilled 195 ft. Depth cased 195 ft.

CASING RECORD:  
10 inch

FINISH:  
Perforated: slots from 50 to 195 ft.

AQUIFERS:

WATER LEVEL:  
18 ft. (July)

PUMPING EQUIPMENT: Type Berkeley turbine H.P. 7 1/2  
Capacity 150 G.P.M.

WELL TESTS:  
Drawdown 82 ft. after 150 hours G.P.M.  
Drawdown ft. after hours G.P.M.

USE OF WATER Irrigation Temp. °F., 19  
SOURCE OF INFORMATION G. R. Record  
DRILLER or DIGGER Blair

ADDITIONAL DATA:  
Log Water Level Measurements Chemical Analysis Aquifer Test

REMARKS:  
Log: Soil & clay 0 to 6 ft.  
Silt, clay & sand 6 to 195 ft.

Irrigation of 54.2 acres.