

STATE ENGINEER
Salem, Oregon

WASH
009651

Well Record

STATE WELL NO. 1/2W - 8M
COUNTY WASHINGTON
APPLICATION NO. GR-2012

OWNER: Rudolph E. Zagelow


MAILING ADDRESS: Rt. 4, Box 139

LOCATION OF WELL: Owner's No. _____

CITY AND STATE: Hillsboro, Oregon

NW $\frac{1}{4}$ SW $\frac{1}{4}$ Sec. 8 T. 1 N. S., R. 2 E. W., W.M.

Bearing and distance from section or subdivision corner N 29° 0' E. 2280'

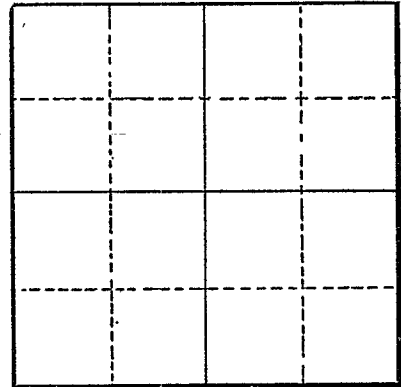

Section _____

Altitude at well _____

TYPE OF WELL: Drilled Date Constructed 1954

Depth drilled 60 Depth cased 65

CASING RECORD:

8-inch

FINISH:

Perforation from 0 to 65

AQUIFERS:

Top soil, clay and sand

WATER LEVEL:

19-feet

PUMPING EQUIPMENT: Type Jet

H.P. 3

Capacity 63 G.P.M.

WELL TESTS:

Drawdown 3 ft. after _____ hours Pumping 100 G.P.M.

Drawdown _____ ft. after _____ hours _____ G.P.M.

USE OF WATER Irrigation Temp. _____ °F. _____, 19

SOURCE OF INFORMATION GR-1940

DRILLER or DIGGER Lee Barton

ADDITIONAL DATA:

Log Water Level Measurements _____ Chemical Analysis _____ Aquifer Test _____

REMARKS:

Top soil 3 3
Clay 2 5
Sand 14 19

From 19' down sand and clay layers alternated with about 2' layers of clay and 3' layers of Sand to 60'.