

STATE ENGINEER
Salem, Oregon

WASH

Well Record

STATE WELL NO. 1/2W - 8M
COUNTY WASHINGTON
APPLICATION NO. GR-2190

009656

OWNER: Clarence and Clementine Josten


MAILING ADDRESS: Rt. 4, Box 144

LOCATION OF WELL: Owner's No.

CITY AND STATE: Hillsboro, Oregon

NW 1/4 SW 1/4 Sec. 8 T. 1 S., R. 2 W., W.M.

Bearing and distance from section or subdivision corner N. 35° 0' E. 1880'

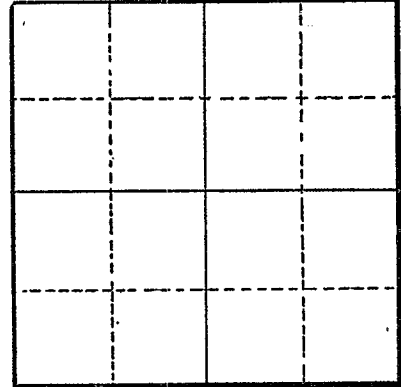

Section

Altitude at well

TYPE OF WELL: Drilled Date Constructed 1948

Depth drilled 58 Depth cased 58

CASING RECORD:

6-Inch

FINISH:

AQUIFERS:

WATER LEVEL:

8 - 10-Feet

PUMPING EQUIPMENT: Type Berkeley Jet

H.P. 2

Capacity 30 G.P.M.

WELL TESTS:

Drawdown 18-20 ft. after hours Pumping 30 G.P.M.

Drawdown ft. after hours G.P.M.

USE OF WATER Irrigation Temp. °F. 19

SOURCE OF INFORMATION GR-2095

DRILLER or DIGGER Ralph La Crone, Cornelius, Oregon

ADDITIONAL DATA:

Log Water Level Measurements Chemical Analysis Aquifer Test

REMARKS: