

STATE ENGINEER  
Salem, Oregon

WASH Well Record

STATE WELL NO. 1/2W-8P  
COUNTY Washington  
APPLICATION NO. GR-2692

009663

OWNER: Richard M. Alden


MAILING ADDRESS: Route 4, Box 146

LOCATION OF WELL: Owner's No.

CITY AND STATE: Hillsboro, Oregon

SE 1/4 SW 1/4 Sec. 8 T. 1 S., R. 2 W., W.M.

Bearing and distance from section or subdivision corner 396.4' from E. Line and 374.5' from N. Line of Lot 8

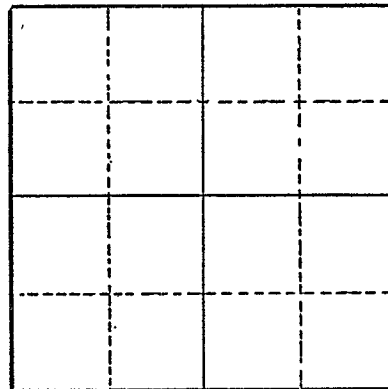

Section

Altitude at well

TYPE OF WELL: Drilled Date Constructed 1950

Depth drilled 52' Depth cased 42'

CASING RECORD:

6 inch

FINISH:

AQUIFERS:

Loam, Clay, and Sand

WATER LEVEL:

8 to 12 feet

PUMPING EQUIPMENT: Type Berkeley Jet H.P. 1 1/2  
Capacity 80 G.P.M.

WELL TESTS:

Drawdown 4 ft. after hours pumping 200 G.P.M.  
Drawdown ft. after hours G.P.M.

USE OF WATER irrigation Temp. °F. 19

SOURCE OF INFORMATION GR-2550

DRILLER or DIGGER

ADDITIONAL DATA:

Log X Water Level Measurements Chemical Analysis Aquifer Test

REMARKS:

Amity Loam 8 to 8  
Brown Clay 10 to 18  
Black Sand & Blue Clay 34 to 52  
(Water bearing below 8')