

STATE ENGINEER
Salem, Oregon

WASH

Well Record

STATE WELL NO. 1/2W-9E
COUNTY WASHINGTON
APPLICATION NO. GR-2592

009670

OWNER: Roy J. and Sidney E. Mosner


MAILING ADDRESS: 3080 SW River Road

LOCATION OF WELL: Owner's No.

CITY AND STATE: Hillsboro, Oregon

SW 1/4 NW 1/4 Sec. 9 T. 1 N. S. R. 2 E. W.M.

Bearing and distance from section or subdivision corner 280' E. of N. from 1/4 corner on W. line of Sec. 9

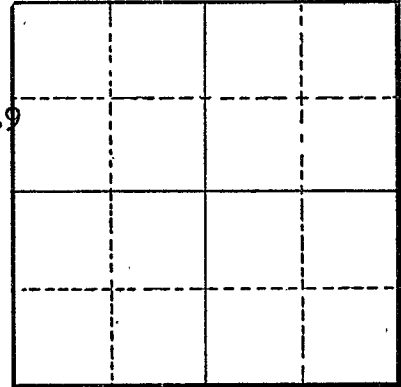

Section

Altitude at well

TYPE OF WELL: Drilled Date Constructed 1953

Depth drilled 55 Depth cased 55

CASING RECORD:

6-inch
5-inch

FINISH:

4 perforations from 1/8 x 12 feet from 42 to 55

AQUIFERS:

Clay, sand and rock

WATER LEVEL:

21-feet

PUMPING EQUIPMENT: Type Pacific H.P. 1 1/2
Capacity 21 G.P.M.

WELL TESTS:

Drawdown 9 ft. after hours Pumping 42 G.P.M.
Drawdown ft. after hours G.P.M.

USE OF WATER Irrigation Temp. °F. , 19

SOURCE OF INFORMATION GR-2459

DRILLER or DIGGER A. H. Jamsen Drilling Co.

ADDITIONAL DATA:

Log X Water Level Measurements Chemical Analysis Aquifer Test

REMARKS:

Brown clay with sand	32	32
Blue clay	3	35
Clay and sand	8	43
Sand & small amount clay	5	48
Decomposed rock	7	55