

STATE ENGINEER
Salem, Oregon

WASH

Well Record

STATE WELL NO. 1/2W-9J
COUNTY Washington
APPLICATION NO. GR-1528

GR-1530

009676

OWNER: Ralph R. Roediger

MAILING

ADDRESS: 3485 247th Ave.

LOCATION OF WELL: Owner's No.

CITY AND


STATE: Hillsboro, Oregon

NE 1/4 SE 1/4 Sec. 9 T. 1 S., R. 2 W., W.M.

Bearing and distance from section or subdivision

corner 348' S. & 195' W. on Lot 22 of Witch Hazel

Little Farms or more specifically - 1050' S. &
700' W. from E 1/4 cor. Sec. 9

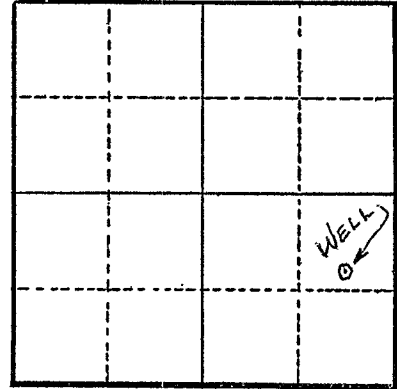

Section 9

Altitude at well

TYPE OF WELL: Drilled Date Constructed 1950

Depth drilled 36' Depth cased 32'

CASING RECORD:

6"

FINISH:

AQUIFERS:

WATER LEVEL:

14'

PUMPING EQUIPMENT: Type Pacific JN7 H.P. 2

Capacity 34 G.P.M.

WELL TESTS:

Drawdown 14 ft. after 34 hours G.P.M.

Drawdown ft. after hours G.P.M.

USE OF WATER Irrigation Temp. °F. 19

SOURCE OF INFORMATION GR Record

DRILLER or DIGGER

ADDITIONAL DATA:

Log N.A. Water Level Measurements Chemical Analysis Aquifer Test

REMARKS:

Irrigation of 20 acres.