

STATE ENGINEER
Salem, Oregon

WASH

Well Record

STATE WELL NO. 1/2W-9G
COUNTY Washington
APPLICATION NO. GR-1404

009677

GR-1359

OWNER: Boyd Raymond Darnall


MAILING ADDRESS: 25470 Tualitan Valley Hwy.

LOCATION OF WELL: Owner's No. #1

CITY AND STATE: Hillsboro, Oregon

SW 1/4 NE 1/4 Sec. 9 T. 1 S., R. 2 W., W.M.

Bearing and distance from section or subdivision corner S. 54° W. 1090' from NE cor. Sec. 9

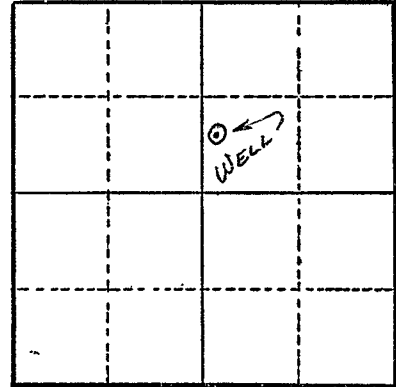

Section 9

Altitude at well

TYPE OF WELL: Augered Date Constructed 1950

Depth drilled 35 ft. Depth cased 35 ft.

CASING RECORD:

6 or 8 in. //???

FINISH:

AQUIFERS:

WATER LEVEL:

25 ft. (June)

PUMPING EQUIPMENT: Type Myers jet H.P. 2

Capacity 30 G.P.M.

WELL TESTS:

Drawdown ft. after hours G.P.M.

Drawdown ft. after hours G.P.M.

USE OF WATER Irrigation Temp. °F. 19

SOURCE OF INFORMATION G. R. Record

DRILLER or DIGGER Owner

ADDITIONAL DATA:

Log Water Level Measurements Chemical Analysis Aquifer Test

REMARKS:

Log: Sandy loam, mixed sand & clay 0 to 35 ft.

Irrigation of 5.5 acres.