

STATE ENGINEER
Salem, Oregon

WASH

Well Record

STATE WELL NO. 1/2W-9L
COUNTY Washington
APPLICATION NO. GR-3094

009681

OWNER: Ralph M. Thomison


MAILING ADDRESS: 25975 S. W. Witch Hazel Road

LOCATION OF WELL: Owner's No.

CITY AND STATE: Hillsboro, Oregon

NE 1/4 SW 1/4 Sec. 9 T. 1 S., R. 2 W., W.M.

Bearing and distance from section or subdivision corner 1550 feet E.

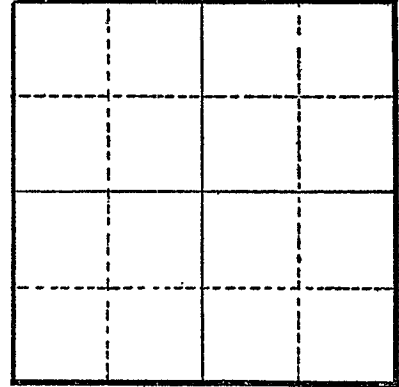

Section

Altitude at well

TYPE OF WELL: Drilled Date Constructed 1941

Depth drilled 32 feet Depth cased 32 feet

CASING RECORD:

6-inch

FINISH:

AQUIFERS:

WATER LEVEL:

18 feet

PUMPING EQUIPMENT: Type Pacific Jet H.P. 1

Capacity 20 G.P.M.

WELL TESTS:

Drawdown 26 ft. after hours Pumping 15 G.P.M.

Drawdown ft. after hours G.P.M.

USE OF WATER Irrigation Temp. °F. 19

SOURCE OF INFORMATION GR-2902

DRILLER or DIGGER

ADDITIONAL DATA:

Log Water Level Measurements Chemical Analysis Aquifer Test

REMARKS: