

STATE ENGINEER  
Salem, Oregon

**WASH** Well Record  
009688

STATE WELL NO. 1/2W - 9G  
COUNTY WASHINGTON  
APPLICATION NO. GR-1972

OWNER: John H. Koffel


MAILING ADDRESS: 25215 S. W. T. V. Highway

LOCATION OF WELL: Owner's No. \_\_\_\_\_

CITY AND STATE: Hillsboro, Oregon

SW 1/4 NE 1/4 Sec. 9 T. 1 S., R. 2 M. E. W., W.M.

Bearing and distance from section or subdivision corner 90.8' E. 1430' S. 1780' W.

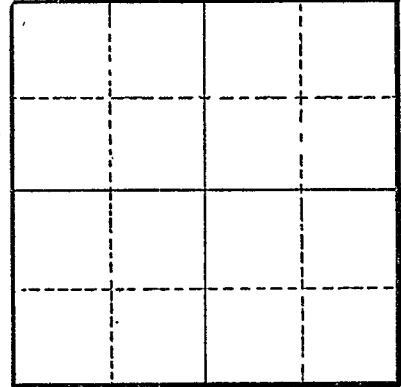

Section \_\_\_\_\_

Altitude at well \_\_\_\_\_

TYPE OF WELL: Drilled Date Constructed 1952

Depth drilled 36' Depth cased 32'

CASING RECORD:

6-inch

FINISH:

AQUIFERS:

Soil, Sand and Clay Shale

WATER LEVEL:

17-feet

PUMPING EQUIPMENT: Type Peerless Jet H.P. 1  
Capacity 20 G.P.M.

WELL TESTS:  
Drawdown 22 ft. after \_\_\_\_\_ hours Pumping 20 G.P.M.  
Drawdown \_\_\_\_\_ ft. after \_\_\_\_\_ hours \_\_\_\_\_ G.P.M.

USE OF WATER Irrigation Temp. \_\_\_\_\_ °F. \_\_\_\_\_, 19\_\_\_\_\_

SOURCE OF INFORMATION GR-1900  
DRILLER or DIGGER Drilled themselves.

ADDITIONAL DATA:

Log  Water Level Measurements \_\_\_\_\_ Chemical Analysis \_\_\_\_\_ Aquifer Test \_\_\_\_\_

REMARKS:

Soil 17 to 17  
Sand 10 to 27  
Clay shale 5 to 32