

STATE ENGINEER  
Salem, Oregon

WASH  
009737

# Well Record

STATE WELL NO. 1/2W-10H  
COUNTY Washington  
APPLICATION NO. GR-2654

OWNER: Henry Hausch & Julie E. Hausch  
dba Roseway Nurseries


MAILING ADDRESS: 2935 S.W. 234th Ave.

LOCATION OF WELL: Owner's No.

CITY AND STATE: Beaverton, Oregon

SW 1/4 NE 1/4 Sec. 10 T. 1 N. S, R. 2 E. W., W.M.

Bearing and distance from section or subdivision  
corner 2530 ft. W. and 100 ft. N. of the 1/4 corner  
on the East line of said Sec. 10 Witch Hazel Little  
Farms.

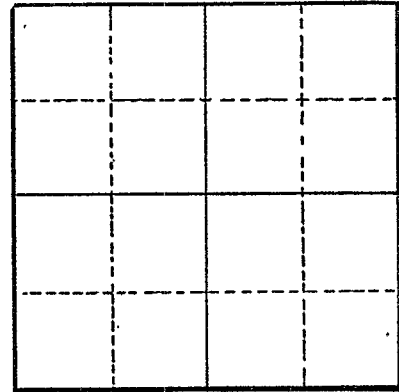

Section

Altitude at well

TYPE OF WELL: drilled Date Constructed 1954

Depth drilled 191' Depth cased 191'

### CASING RECORD:

24 inch and 10 inch

### FINISH:

Torch perforations 1/8" x 12" 4 per foot from 150 to 191

### AQUIFERS:

clay, gravel and sand

### WATER LEVEL:

15 feet

PUMPING EQUIPMENT: Type Universal Jacuzzi turbine H.P. 15  
Capacity 105 G.P.M.

### WELL TESTS:

Drawdown 165 ft. after hours pumping 110 G.P.M.  
Drawdown ft. after hours G.P.M.

USE OF WATER irrigation Temp. °F. 19

SOURCE OF INFORMATION GR-2516

DRILLER or DIGGER A.M. Janssen Drilling Co. 21075 S.W. Tualatin Hwy., Aloha, Oregon

### ADDITIONAL DATA:

Log  Water Level Measurements Chemical Analysis Aquifer Test

REMARKS: brown & blue sandy clay 0 to 92  
brown clay 92 to 168  
sand & gravel 168 to 173  
blue sand 173 to 183  
blue clay 183 to 191