

STATE ENGINEER
Salem, Oregon

WASH

Well Record

STATE WELL NO. 1/2W-10H
COUNTY Washington
APPLICATION NO. GR-3099

OWNER: Robert B. Evans 009739


MAILING ADDRESS: 22935 S. W. Johnson Court

LOCATION OF WELL: Owner's No.

CITY AND STATE: Beaverton, Oregon

SE 1/4 NE 1/4 Sec. 10 T. 1 N. S., R. 2 E. W.M.

Bearing and distance from section or subdivision corner 1229 feet N. & 650 feet W.

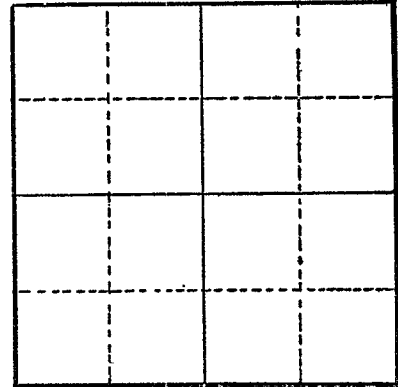

Section

Altitude at well

TYPE OF WELL: Drilled Date Constructed 1953

Depth drilled 52 feet Depth cased 46 feet

CASING RECORD:

4-inch

FINISH:

AQUIFERS:

WATER LEVEL:

18 feet

PUMPING EQUIPMENT: Type M. W. Jet 1 1/4" H.P. 1/3
Capacity 11 G.P.M.

WELL TESTS:

Drawdown 2 1/4 ft. after hours Pumping 7 1/2 G.P.M.
Drawdown 6 ft. after hours Pumping 11 G.P.M.

USE OF WATER Irrigation Temp. °F. 19

SOURCE OF INFORMATION GR-2907
DRILLER or DIGGER Robert B. Evans

ADDITIONAL DATA:

Log Water Level Measurements Chemical Analysis Aquifer Test

REMARKS: