

STATE ENGINEER
Salem, Oregon

WASH

Well Record

STATE WELL NO. 1/2W-10F
COUNTY Washington
APPLICATION NO. GR-1489

009752

GR-1437

OWNER: P. R. and/or Caroline Mulle


MAILING ADDRESS: 23635 Tualatin Valley Hwy.

LOCATION OF WELL: Owner's No.

CITY AND STATE: Aloha, Oregon

SE 1/4 NW 1/4 Sec. 10 T. 1 S., R. 2 W., W.M.

Bearing and distance from section or subdivision corner 200' W. & 150' N. from Center Sec. 10

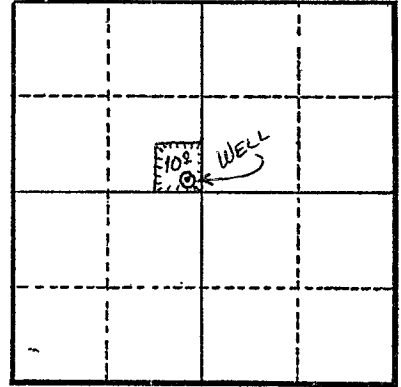

Section 10

Altitude at well 200'

TYPE OF WELL: Dug Date Constructed 1952

Depth drilled 30' Depth cased 30'

CASING RECORD:
36"

FINISH:

AQUIFERS:

WATER LEVEL:
9'

PUMPING EQUIPMENT: Type Dorward 2" jet H.P. 2
Capacity 60 G.P.M.

WELL TESTS:

Drawdown	13	ft. after	hours	16	G.P.M.
Drawdown	20	ft. after	hours	24	G.P.M.

USE OF WATER Irrigation Temp. °F. 19

SOURCE OF INFORMATION GR Record

DRILLER or DIGGER A. J. Leopold

ADDITIONAL DATA:

Log N.A. Water Level Measurements Chemical Analysis Aquifer Test

REMARKS:

Irrigation of 10 acres