

STATE ENGINEER
Salem, Oregon

WASH

Well Record

STATE WELL NO. 1/2W-11J
COUNTY Washington
APPLICATION NO. GR-2059

OWNER: Loren H. Slade 009769

MAILING ADDRESS: 3140 SW 209 Ave.

LOCATION OF WELL: Owner's No.


CITY AND STATE: Aloha, Oregon

NE 1/4 SE 1/4 Sec. 11 T. 1 S., R. 2 W., W.M.

Bearing and distance from section or subdivision

corner 625 feet West and 220 feet South from E 1/4 corner, Section 11. 1691.7 feet from NW Corner of

claim part of Andrew Masters DLC 46

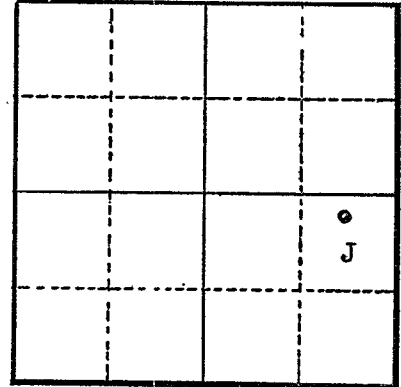

Altitude at well 60 feet

TYPE OF WELL: Dug Date Constructed Aug. 1, 1951

Depth drilled 70 feet Depth cased 70 feet

Section 11

CASING RECORD:

12-inch cement tile set from top to 70 feet

FINISH:

AQUIFERS:

clay, sand, & gravel

WATER LEVEL:

2 feet 3 inches

PUMPING EQUIPMENT: Type Meyer H.P.
Capacity 30 G.P.M.

WELL TESTS: Drawdown 12' 9" ft. after 30 hours G.P.M.
Drawdown ft. after hours G.P.M.

USE OF WATER Irrigation Temp. °F., 19

SOURCE OF INFORMATION GR-4011

DRILLER or DIGGER R. W. Duncan

ADDITIONAL DATA:

Log x Water Level Measurements Chemical Analysis Aquifer Test

REMARKS:

