

STATE ENGINEER
Salem, Oregon

WASH

Well Record

009776

STATE WELL NO. 1/2N-100
COUNTY Washington
APPLICATION NO. BR-3573

OWNER: Kenneth L. Martin


MAILING ADDRESS: Route 2, Box 506

LOCATION OF WELL: Owner's No.

CITY AND STATE: Beaverton, Oregon

SW 1/4 SE 1/4 Sec. 10 T. 1 S. R. 2 W., W.M.

Bearing and distance from section or subdivision
corner 1400 ft. west and 730 ft. north from S.E.
corner Sec. 10

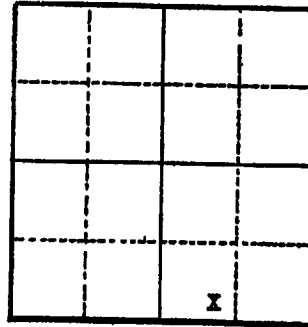

Section 10

Altitude at well

TYPE OF WELL: Drilled Date Constructed 6/13/55

Depth drilled 115 ft. Depth cased 115 ft.

CASING RECORD:

6 inch casing from 0 to 72 feet
5 3/8 inch casing from 68 to 115 feet

FINISH:

AQUIFERS:

WATER LEVEL:

PUMPING EQUIPMENT: Type Barnes Jet H.P. 3
Capacity 20 G.P.M.

WELL TESTS:

Drawdown 50 ft. after 20 hours G.P.M.

Drawdown ft. after hours G.P.M.

USE OF WATER Irrigation Temp. °F. 19

SOURCE OF INFORMATION Well Registration Statement

DRILLER or DIGGER

ADDITIONAL DATA:

Log X Water Level Measurements Chemical Analysis Aquifer Test

REMARKS:

