

STATE ENGINEER
Salem, Oregon

P.O. Box 238 Hills

7-1-71 WSR.

Washington Federal Savings & Loan Co. Purchase property.

Well Record

009797


STATE WELL NO. 1/2W-12R
COUNTY ~~Washington~~ Washington
APPLICATION NO. GR-3130

OWNER: ~~Golden West Frozen Food Lockers Inc.~~ ADDRESS: 1815 Trade St.

LOCATION OF WELL: Owner's No. _____ CITY AND STATE: Salem, Oregon

SE 1/4 SE 1/4 Sec. 12 T. 1 S., R. 2 W., W.M.

Bearing and distance from section or subdivision corner 1180' N & 840' W from SE cor Sec 12

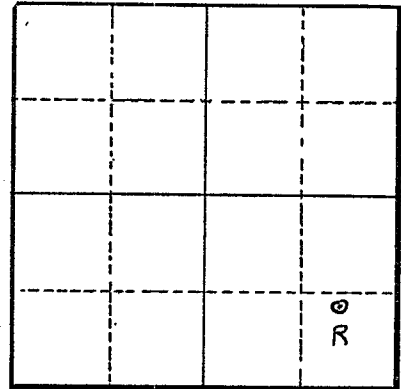

Section 12

Altitude at well _____

TYPE OF WELL: Drilled Date Constructed 1946

Depth drilled 170' Depth cased 161' 9"

CASING RECORD:
6-inch

FINISH:
perforated 158' to 170'

AQUIFERS:

WATER LEVEL:
60'

PUMPING EQUIPMENT: Type Peerless Hi-Lift, Model 25734 H.P. 3
Capacity 15-18 G.P.M.

WELL TESTS:
Drawdown 30 ft. after _____ hours 25 G.P.M.
Drawdown _____ ft. after _____ hours _____ G.P.M.

USE OF WATER Cooling Refrigeration Equip Temp. _____ °F., 19

SOURCE OF INFORMATION GR-3909
DRILLER or DIGGER Janson Well Drilling Co.

ADDITIONAL DATA:
Log ^{NA} Water Level Measurements _____ Chemical Analysis _____ Aquifer Test _____

REMARKS:

OK on Abn. of this well by Wash. Federal Savings & Loan.

PH - Robert Fahn or Howard Hughes
648-4131