

STATE ENGINEER
Salem, Oregon

WASH

Well Record

STATE WELL NO. 12W-13A
COUNTY WASHINGTON
APPLICATION NO. GR-1149


009818

OWNER: Theodore O. & Ruth Irene Hakkinen MAILING ADDRESS: 1875 S. W. 198 Ave

LOCATION OF WELL: Owner's No. _____ CITY AND STATE: Aloha, Washington

NE 1/4 NE 1/4 Sec. 13 T. 1 S., R. 2 W., W.M.

Bearing and distance from section or subdivision corner 510' S & 260' W from NE cor Sec 13

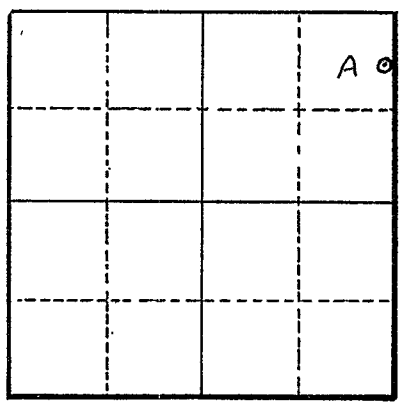

Section 13

Altitude at well _____

TYPE OF WELL: Drilled Date Constructed 1954

Depth drilled 160' Depth cased 111'

CASING RECORD:

6-inch

FINISH:

40' perforated

AQUIFERS:

Brown clay, blue clay, small gravel, sand

WATER LEVEL:

20'

PUMPING EQUIPMENT: Type Homart H.P. 3
Capacity 20 G.P.M.

WELL TESTS:

Drawdown 35 ft. after _____ hours 20 G.P.M.
Drawdown _____ ft. after _____ hours _____ G.P.M.

USE OF WATER Irrigation Temp. _____ °F. _____, 19

SOURCE OF INFORMATION GR-3962

DRILLER or DIGGER _____

ADDITIONAL DATA:

Log X Water Level Measurements _____ Chemical Analysis _____ Aquifer Test _____

REMARKS:

