

STATE ENGINEER
Salem, Oregon

WASH

Well Record

STATE WELL NO. 1/2W-13G
COUNTY Washington
APPLICATION NO. GR-4001

009822

OWNER: Joseph W. Bates


MAILING ADDRESS: 4555 SW 191st Ave.

LOCATION OF WELL: Owner's No. _____

CITY AND STATE: Aloha, Oregon

SW 1/4 NE 1/4 Sec. 13 T. 1 S., R. 2 W., W.M.

Bearing and distance from section or subdivision
corner 1750' W. & 1450' S. from NE Cor. Sec. 13

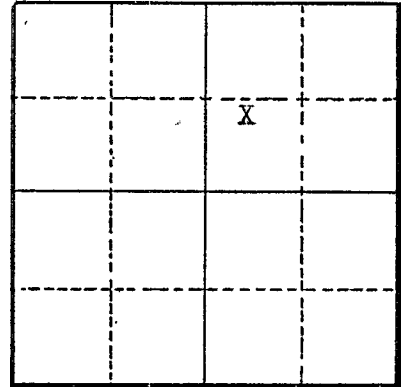

Section 13

Altitude at well _____

TYPE OF WELL: Drilled Date Constructed 5/14/52

Depth drilled 125 ft. Depth cased 110 ft.

CASING RECORD:

6 inch casing set to 110 feet

FINISH:

AQUIFERS:

WATER LEVEL:

80 feet below surface

PUMPING EQUIPMENT: Type Fairbanks Morse H.P. 1

Capacity 580 G.P.M.

WELL TESTS:

Drawdown _____ ft. after _____ hours _____ G.P.M.

Drawdown _____ ft. after _____ hours _____ G.P.M.

USE OF WATER Irrigation Temp. _____ °F. _____, 19_____

SOURCE OF INFORMATION Well Registration Statement Cert. # GR-3608

DRILLER or DIGGER A. J. Gaunt

ADDITIONAL DATA:

Log Water Level Measurements _____ Chemical Analysis _____ Aquifer Test _____

REMARKS:

Log:

	Thickness	Depth to Bottom
Soil	20	105
Blue clay	92	13
Rock	13	0