

STATE ENGINEER
Salem, Oregon

WASH

Well Record

STATE WELL NO. 1/2W-14K
COUNTY Washington
APPLICATION NO. GR-1386

009862

GR-1343

OWNER: James L. Kincheloe


MAILING ADDRESS: Rt. 2, Box 461

LOCATION OF WELL: Owner's No.

CITY AND STATE: Beaverton, Oregon

NW 1/4 SE 1/4 Sec. 14 T. 1 S., R. 2 W., W.M.

Bearing and distance from section or subdivision corner 780' S. 33° E. from Center of Sec. 14.

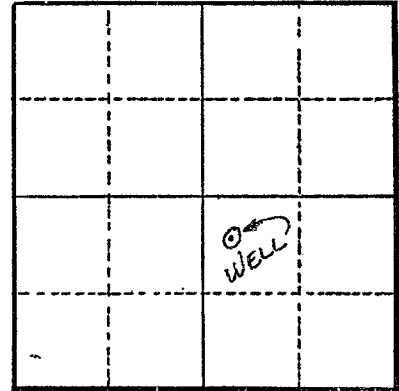

Section 14

Altitude at well 200 ft.

TYPE OF WELL: Drilled Date Constructed 1930

Depth drilled 165 ft. Depth cased 165 ft.

CASING RECORD:

6 in.

FINISH:

AQUIFERS:

WATER LEVEL:

30 ft.

PUMPING EQUIPMENT: Type Myers Ejecto H.P. 3/4

Capacity G.P.M.

WELL TESTS:

Drawdown ft. after hours G.P.M.

Drawdown ft. after hours G.P.M.

USE OF WATER Irrigation Temp. °F. 19

SOURCE OF INFORMATION G. R. Record

DRILLER or DIGGER Art Gaunt

ADDITIONAL DATA:

Log N.A. Water Level Measurements Chemical Analysis Aquifer Test

REMARKS:

Irrigation of 1 acre.