

STATE ENGINEER
Salem, Oregon

WASH

Well Record

STATE WELL NO. 1/2W - 16H
COUNTY WASHINGTON
APPLICATION NO. GR-1979

009910

OWNER: Charles E. Walters


MAILING ADDRESS: Rt. 2, Box 265

LOCATION OF WELL: Owner's No.

CITY AND STATE: Hillsboro, Oregon

SE 1/4 NE 1/4 Sec. 16 T. 1 S., R. 2 N. W., W.M.

Bearing and distance from section or subdivision corner 1860' S. 27° 0' W.

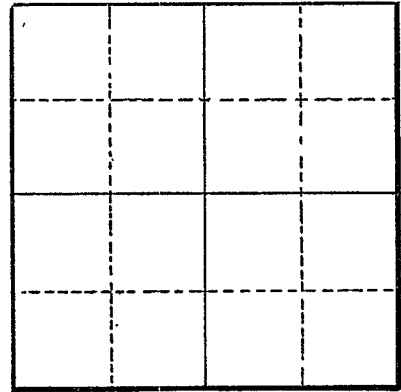

Altitude at well

TYPE OF WELL: Drilled Date Constructed 1954

Depth drilled 42' Depth cased 42'

Section

CASING RECORD:

6-inch

FINISH:

AQUIFERS:

WATER LEVEL:

16-feet

PUMPING EQUIPMENT: Type Delco 1 1/2" Jet H.P. 1
Capacity 40 G.P.M.

WELL TESTS:
Drawdown 28 ft. after hours Pumping 32 G.P.M.
Drawdown ft. after hours G.P.M.

USE OF WATER Irrigation Temp. °F., 19.....

SOURCE OF INFORMATION GR-1910

DRILLER or DIGGER Lee Barton Route 1, Hillsboro, Oregon

ADDITIONAL DATA:
Log Water Level Measurements Chemical Analysis Aquifer Test

REMARKS:

Log unknown