

STATE ENGINEER
Salem, Oregon

WASH

Well Record

STATE WELL NO. W-15K0
COUNTY Wash.
APPLICATION NO. GR-399

009981

OWNER: Lloyd O. Edmister


MAILING ADDRESS: _____

LOCATION OF WELL: Owner's No. _____

CITY AND STATE: Hillsboro, Ore

NW 1/4 SE 1/4 Sec. 18 T. 1 S., R. 2 W., W.M.

Bearing and distance from section or subdivision corner 17 ch. 40 ft. E. Flam
N.E. cor. N. C. Richardson
D.L.C. #63

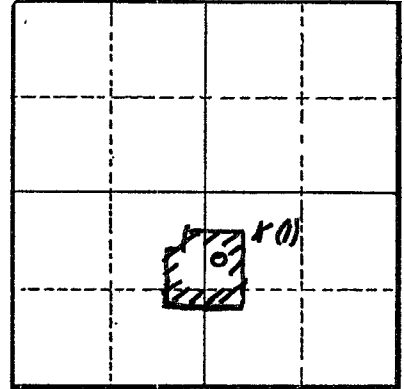

Section 18

Altitude at well 178

TYPE OF WELL: drilled Date Constructed Aug 31, '51

Depth drilled 52 Depth cased 52

CASING RECORD:

8 inch

FINISH:

AQUIFERS:

WATER LEVEL:

10 ft.

PUMPING EQUIPMENT: Type Fairbanks Morse H.P. 3
Capacity 50 G.P.M.

WELL TESTS:

Drawdown _____ ft. after _____ hours _____ G.P.M.
Drawdown _____ ft. after _____ hours _____ G.P.M.

USE OF WATER irrigation - 18.3 ac. Temp. _____ °F. _____, 19.

SOURCE OF INFORMATION GR-399

DRILLER or DIGGER Perkins Well Drilling; Banks, Ore

ADDITIONAL DATA:

Log _____ Water Level Measurements _____ Chemical Analysis _____ Aquifer Test _____

REMARKS: