

STATE ENGINEER
Salem, Oregon

WASH Well Record

STATE WELL NO. 1/2W-18M
COUNTY WASHINGTON
APPLICATION NO. GR-2788

009983

OWNER: Earl N. Grabel


MAILING ADDRESS: Rt. 4, Box 168

LOCATION OF WELL: Owner's No.

CITY AND STATE: Hillsboro, Oregon

NW 1/4 SW 1/4 Sec. 18 T. 1 N. S., R. 2 E. W., W.M.

Bearing and distance from section or subdivision corner 60 rods E. and 60' N.

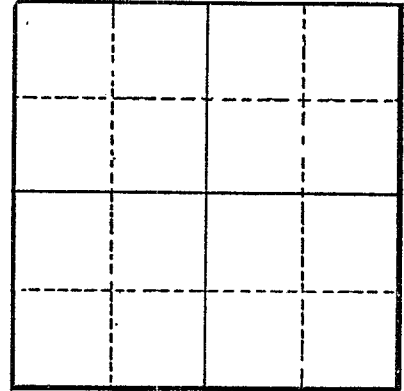

Section

Altitude at well

TYPE OF WELL: drilled Date Constructed

Depth drilled 125 Depth cased 120

CASING RECORD:

6-inch

FINISH:

Open end casing

AQUIFERS:

Clay, mud and sand

WATER LEVEL:

25-feet

PUMPING EQUIPMENT: Type Jet H.P. 2
Capacity 30 G.P.M.

WELL TESTS:
Drawdown 55 ft. after hours Pumping 20 G.P.M.
Drawdown ft. after hours G.P.M.

USE OF WATER Irrigation Temp. °F., 19

SOURCE OF INFORMATION GR-2635

DRILLER or DIGGER R. Bowman, Jansen Well Drilling, Aloha, Oregon

ADDITIONAL DATA:
Log Water Level Measurements Chemical Analysis Aquifer Test

REMARKS:

Top clay	0	25	100
Yellow sandy clay	25	55	
Blue mud	55	90	
Sandy clay	90	110	
Blue sticky clay	110	115	
Water and sand	115	125	