

STATE ENGINEER
Salem, Oregon

WASH Well Record
009985

STATE WELL NO. W-18P(1)
COUNTY Wash.
APPLICATION NO. GR-978

OWNER: Louis R. Malensky

MAILING ADDRESS: Rt. #4


LOCATION OF WELL: Owner's No. #1

CITY AND STATE: Hillsboro, Ore

SE 1/4 SW 1/4 Sec. 18 T. 1 S., R. 2 W., W.M.

Bearing and distance from section or subdivision

corner S. 37° 42' E. 1172.49 FT.
from N.E. cor. N.C. Richardson
DLC #63

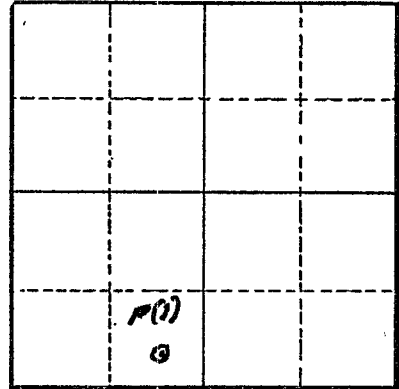

Section 19

Altitude at well 17.5

TYPE OF WELL: drilled Date Constructed Spring '49

Depth drilled 65 Depth cased 65

CASING RECORD:

8 inch

FINISH:

AQUIFERS:

WATER LEVEL:

7

PUMPING EQUIPMENT: Type Centrifugal H.P. 5
Capacity G.P.M.

WELL TESTS:

Drawdown ft. after hours G.P.M.
Drawdown ft. after hours G.P.M.

USE OF WATER irrigation-71.4Ac. Temp. °F., 19.....

SOURCE OF INFORMATION GR-978

DRILLER or DIGGER Perkins, Banks, Ore.

ADDITIONAL DATA:

Log No Water Level Measurements Chemical Analysis Aquifer Test

REMARKS: