

STATE ENGINEER  
Salem, Oregon

WASH

Well Record

STATE WELL NO. 12W-18P6  
COUNTY Wash.  
APPLICATION NO. GR-478

009986

OWNER: Louis R. Malensty


MAILING ADDRESS: Rt. 4

LOCATION OF WELL: Owner's No. # 2

CITY AND STATE: Hillsboro, Ore

SE 1/4 SW 1/4 Sec. 18 T. 1 S., R. 2 W., W.M.

Bearing and distance from section or subdivision corner S. 34° 22' E. 1304.26 ft.  
from N.E. cor. N.C. Richardson  
DLC # 63

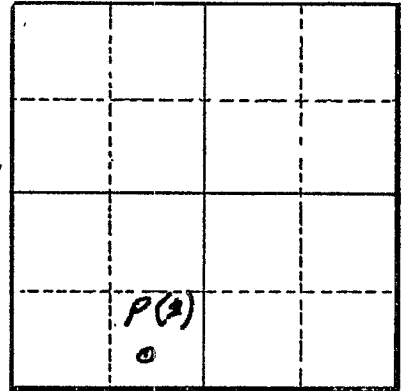

Section 18

Altitude at well 175

TYPE OF WELL: drilled Date Constructed Spring '48

Depth drilled 65 Depth cased 65

CASING RECORD:

6 inch

FINISH:

AQUIFERS:

WATER LEVEL:

7.5

PUMPING EQUIPMENT: Type Centrifugal H.P. 3  
Capacity \_\_\_\_\_ G.P.M.

WELL TESTS:

Drawdown \_\_\_\_\_ ft. after \_\_\_\_\_ hours \_\_\_\_\_ G.P.M.  
Drawdown \_\_\_\_\_ ft. after \_\_\_\_\_ hours \_\_\_\_\_ G.P.M.

USE OF WATER irrigation - 7.4 Ac. Temp. \_\_\_\_\_ °F. \_\_\_\_\_, 19\_\_\_\_

SOURCE OF INFORMATION GR-478

DRILLER or DIGGER Perkins; Banks, Ore.

ADDITIONAL DATA:

Log No. \_\_\_\_\_ Water Level Measurements \_\_\_\_\_ Chemical Analysis \_\_\_\_\_ Aquifer Test \_\_\_\_\_

REMARKS: