WHEE 50302

STATE OF OREGON
WATER SUPPLY WELL REPORT
(as required by ORS 537.765)

WHEE 50302
WELL I.D. # L 57116
START CARD # 152468

Instructions for completing this report are on the last page of this form.

(1) LAND OWNER Well Number L57116
Name Rick Stanley
Address P.O. Box 486
City Fossil State Ore Zip 97830

(2) TYPE OF WORK
☒ New Well ☐ Deepening ☐ Alteration (repair/recondition) ☐ Abandonment

(3) DRILL METHOD:
☐ Rotary Air ☐ Rotary Mud ☒ Cable ☐ Auger
☐ Other

(4) PROPOSED USE:
☒ Domestic ☐ Community ☐ Industrial ☐ Irrigation
☐ Thermal ☐ Injection ☐ Livestock ☐ Other

(5) BORE HOLE CONSTRUCTION:
Special Construction approval ☐ Yes ☒ No Depth of Completed Well 230 ft.
Explosives used ☐ Yes ☐ No Type Amount

HOLE Diameter	From	To	SEAL Material	From	To	Sacks or pounds
10"	GL	-20	Bentonite	GL	-20	1250 Pounds
6"	-20	-230				

How was seal placed: Method ☐ A ☐ B ☐ C ☐ D ☐ E
☐ Other Poured + Tamped
Backfill placed from ft. to ft. Material
Gravel placed from ft. to ft. Size of gravel

(6) CASING/LINER:

	Diameter	From	To	Gauge	Steel	Plastic	Welded	Threaded
Casing:	6"	+1	-21	250	☒	☐	☒	☐
					☐	☐	☐	☐
					☐	☐	☐	☐
					☐	☐	☐	☐
Liner:	4"	-3	-230		☐	☒	☐	☐
					☐	☐	☐	☐

Drive Shoe used ☐ Inside ☐ Outside ☒ None
Final location of shoe(s)

(7) PERFORATIONS/SCREENS:
☒ Perforations Method Sawed
☐ Screens Type Material

From	To	Slot size	Number	Diameter	Tele/pipe size	Casing	Liner
-140	-160	1/8"	40		4"	☐	☒
-210	-230	1/8"	90			☐	☐
						☐	☐
						☐	☐

(8) WELL TESTS: Minimum testing time is 1 hour
☐ Pump ☒ Bailer ☐ Air ☐ Flowing Artesian

Yield gal/min	Drawdown	Drill stem at	Time
2 gal/min	complete		1 hr.

Temperature of water 54° Depth Artesian Flow Found
Was a water analysis done? ☐ Yes By whom
Did any strata contain water not suitable for intended use? ☐ Too little
☐ Salty ☐ Muddy ☐ Odor ☐ Colored ☐ Other
Depth of strata:

(9) LOCATION OF WELL by legal description:
County Wheeler Latitude Longitude
Township 9S N or S Range 24E E or W. WM.
Section 14 NE 1/4 NE 1/4
Tax Lot 200 Lot Block Subdivision
Street Address of Well (or nearest address) 40604 Parish Creek road

(10) STATIC WATER LEVEL:
70 ft. below land surface. Date 1-22-05
Artesian pressure lb. per square inch Date

(11) WATER BEARING ZONES:
Depth at which water was first found -149

From	To	Estimated Flow Rate	SWL
-149	-152	2 gal min	-70

(12) WELL LOG:
Ground Elevation

Material	From	To	SWL
Dirt + Rock	GL	-3	
Black rock	-3	-149	-70
Sand + gravel	-149	-152	-70
Back rock	-152	-203	-70
Gray Clay Stone	-203	-230	70

RECEIVED
FEB 17 2005
WATER RESOURCES DEPT
SALEM, OREGON

RECEIVED
JUN 03 2005
WATER RESOURCES DEPT
SALEM, OREGON

Date started 10-20-04 Completed 1-27-05

(unbonded) Water Well Constructor Certification:
I certify that the work I performed on the construction, alteration, or abandonment of this well is in compliance with Oregon water supply well construction standards. Materials used and information reported above are true to the best of my knowledge and belief.
WWC Number
Signed Date

(bonded) Water Well Constructor Certification:
I accept responsibility for the construction, alteration, or abandonment work performed on this well during the construction dates reported above. All work performed during this time is in compliance with Oregon water supply well construction standards. This report is true to the best of my knowledge and belief.
WWC Number 1729
Signed Shawn B Davis Date 1-27-05

ORIGINAL – WATER RESOURCES DEPARTMENT FIRST COPY – CONSTRUCTOR SECOND COPY – CUSTOMER

WHEE 50302

RECEIVED
FEB 17 2005
WATER RESOURCES DEPT
SALEM, OREGON

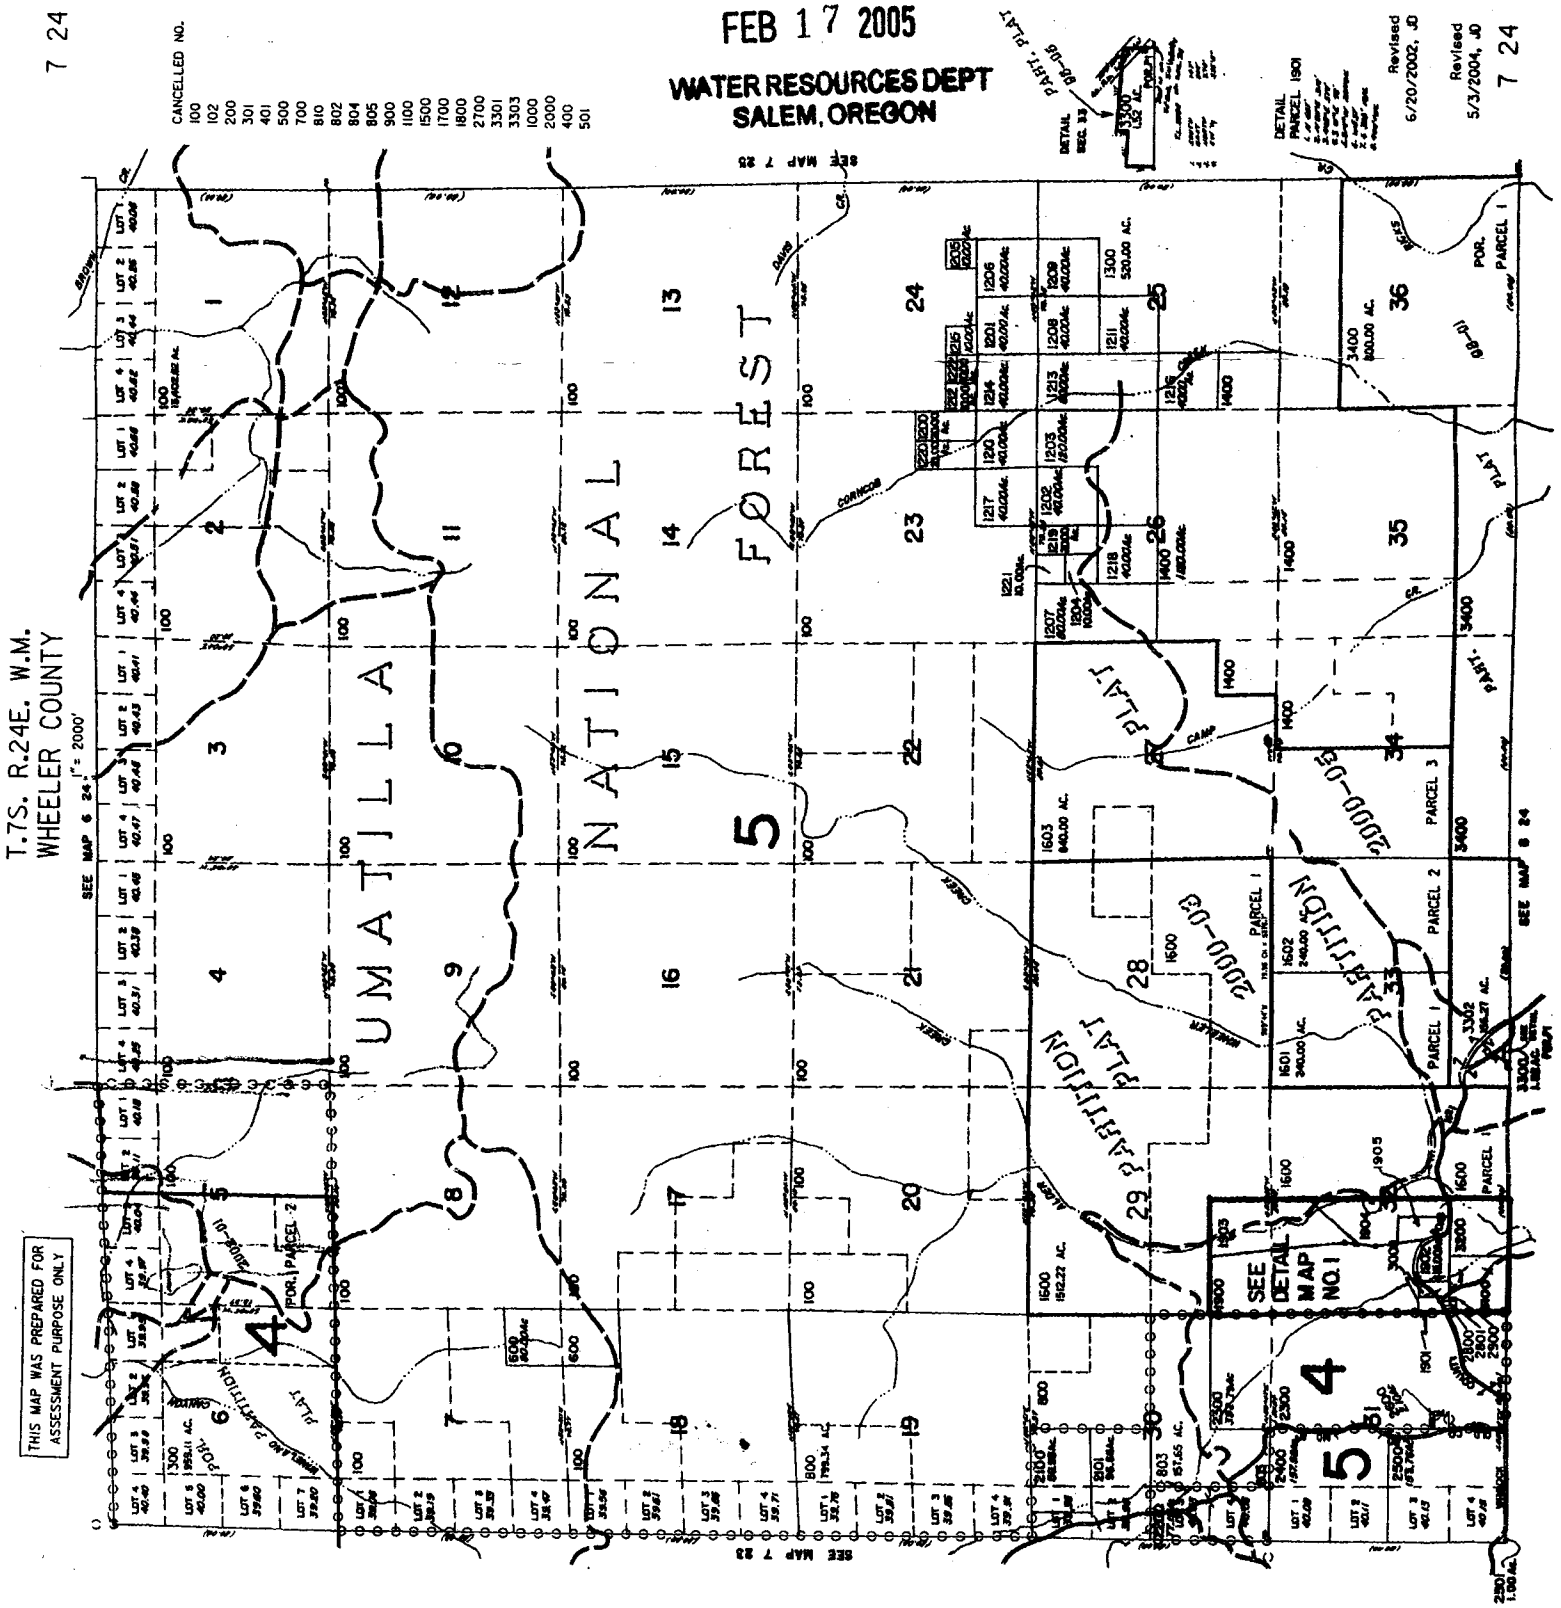

RECEIVED
JUN 03 2005
WATER RESOURCES DEPT
SALEM, OREGON