

STATE ENGINEER  
Salem, Oregon

OBSERVATION WELL  
YAM Well Record

STATE WELL NO. 2/3W-~~200~~ 316(1)  
COUNTY Yamhill  
APPLICATION NO.

M. NAGLEY

1127

G-5972  
G-1477

OWNER: E. W. Leffler

MAILING ADDRESS:

Rt. 2

LOCATION OF WELL: Owner's No.


CITY AND STATE:

Gaston, Oregon

SW 1/4 NE 1/4 Sec. 30 T. 2 S., R. 3 W., W.M.

Bearing and distance from section or subdivision

corner 9 1/2 miles NW of Newberg

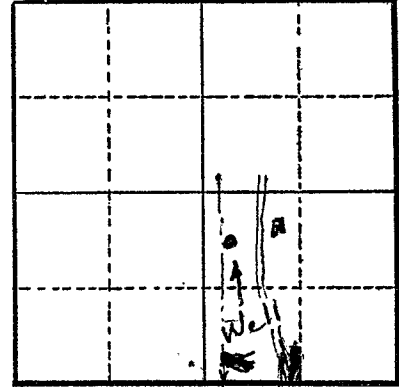

Section 30

Altitude at well 90 ft.

TYPE OF WELL: Drilled Date Constructed 1952

Depth drilled 64 ft. Depth cased 64 ft.

CASING RECORD:

8 inch

FINISH:

25 ft. of perforations from the bottom.

AQUIFERS:

WATER LEVEL:

35 ft.

PUMPING EQUIPMENT: Type Cook turbine

H.P. 5

Capacity 100 G.P.M.

WELL TESTS:

Drawdown ft. after hours G.P.M.

Drawdown ft. after hours G.P.M.

USE OF WATER Dom. & irrigation Temp. °F., 19

SOURCE OF INFORMATION Related registration statement

DRILLER or DIGGER John Wilcox

ADDITIONAL DATA:

Log Water Level Measurements Chemical Analysis Aquifer Test

REMARKS:

Log: Shale 0 to 35 ft.  
Fine silt shale 35 to 55 ft.  
Coarse shale 55 to 64 ft.