

STATE ENGINEER
Salem, Oregon

YAMHILL
1515

Well Record

STATE WELL NO. 2/4W-35M
COUNTY Yamhill
APPLICATION NO. GR-1549

GR- 1567

OWNER: Albert F. & Roy A. DeCreval

MAILING
ADDRESS:

Rt. 2, Box 35


LOCATION OF WELL: Owner's No.

CITY AND
STATE:

Yamhill, Oregon

NW ¼ SW ¼ Sec. 35 T. 2 S, R. 4 W., W.M.

Bearing and distance from section or subdivision
corner 232' E. & 191' N. from NE cor. of the
R. R. Laughlin DLC.

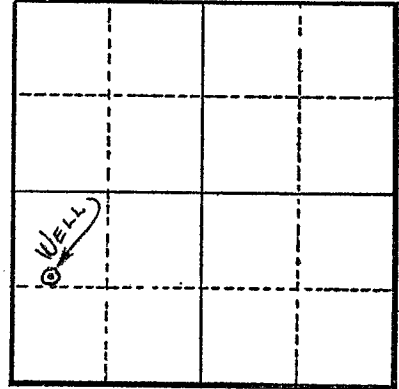

Section 35

Altitude at well 300'

TYPE OF WELL: Drilled Date Constructed 1952

Depth drilled 65' Depth cased ?

CASING RECORD:

8"

FINISH:

AQUIFERS:

WATER LEVEL:

20'

PUMPING EQUIPMENT: Type F. M.

H.P. 3

Capacity 20 G.P.M.

WELL TESTS:

Drawdown ft. after hours G.P.M.

Drawdown ft. after hours G.P.M.

USE OF WATER Irrigation Temp. °F., 19

SOURCE OF INFORMATION GR Record

DRILLER or DIGGER J.L. Wilcox

ADDITIONAL DATA:

Log N.A. Water Level Measurements Chemical Analysis Aquifer Test

REMARKS:

Irrigation of 20 acres.