

STATE ENGINEER
Salem, Oregon

Yard
2158

Well Record

STATE WELL NO. 3/2W-7J
COUNTY YAMHILL
APPLICATION NO. GR-2311

OWNER: Vern Sanford


MAILING ADDRESS: Rt. 1, Box 26 A

LOCATION OF WELL: Owner's No. _____

CITY AND STATE: Newberg, Oregon

NE $\frac{1}{4}$ SE $\frac{1}{4}$ Sec. 7 T. 3 ^{N.} S., R. 2 ^{E.} W., W.M.

Bearing and distance from section or subdivision corner N. 35° W. 2115'

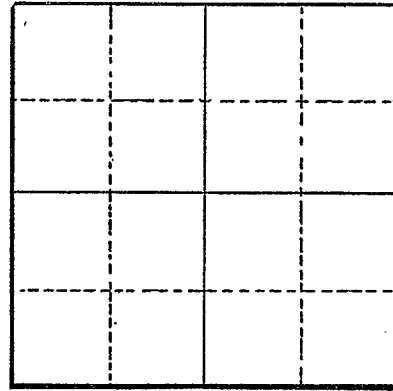

Section _____

Altitude at well _____

TYPE OF WELL: Drilled Date Constructed 1951

Depth drilled 360 Depth cased 360

CASING RECORD:

8-inch
6-inch

FINISH:

6 per foot with torch from 326 to 338
6 per foot with torch from 344 to 356

AQUIFERS:

WATER LEVEL:

100-feet

PUMPING EQUIPMENT: Type Pacific-Beresford Submersible 3" H.P. 10
Capacity 125 G.P.M.

WELL TESTS:

Drawdown 160 ft. after _____ hours Pumping 100 G.P.M.
Drawdown _____ ft. after _____ hours _____ G.P.M.

USE OF WATER Irrigation Temp. _____ °F. _____, 19____

SOURCE OF INFORMATION GR-2202

DRILLER or DIGGER Barron & Strayer, Sorrento Road, Beaverton, Oregon

ADDITIONAL DATA:

Log _____ Water Level Measurements _____ Chemical Analysis _____ Aquifer Test _____

REMARKS: