

STATE ENGINEER
Salem, Oregon

Yamh
2278
Well Record

STATE WELL NO. 3/2W-100
COUNTY Yamhill
APPLICATION NO. GR-3815

OWNER: John McKinley Shaver
Rex Bulb Farm

MAILING

ADDRESS: Route 2.. Box 310

LOCATION OF WELL: Owner's No.


CITY AND

STATE: Newberg, Oregon

SW $\frac{1}{4}$ SE $\frac{1}{4}$ Sec. 10 T. 3 N S, R. 2 E W., W.M.

Bearing and distance from section or subdivision

corner 855' N. & 1458' W. of SE Cor. of Sec. 10

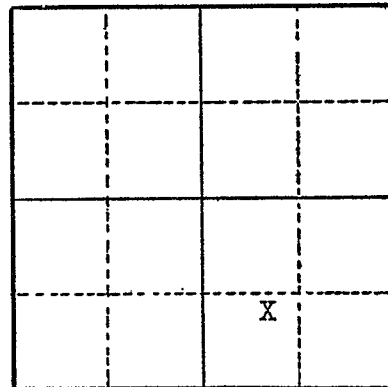

Section 10

Altitude at well

TYPE OF WELL: Drilled Date Constructed 4/20/53

Depth drilled 358 ft. Depth cased 33' 3"

CASING RECORD:

6 inch casing set to 33 ft. 3 in.

FINISH:

Solid rock, No casing below 33' 3"

AQUIFERS:

WATER LEVEL:

330 feet below surface

PUMPING EQUIPMENT: Type Myers Submersible H.P. 2
Capacity 18 G.P.M.

WELL TESTS:

Drawdown 8 ft. after hours 10.5 G.P.M.
Drawdown 10 ft. after hours 15.5 G.P.M.

USE OF WATER Irrigation Temp. °F. 19.....

SOURCE OF INFORMATION Well Registration Statement

DRILLER or DIGGER Steinman Brothers Drilling Company

ADDITIONAL DATA:

Log X Water Level Measurements Chemical Analysis Aquifer Test

REMARKS:

STATE ENGINEER
Salem, Oregon

State Well No. 3/2W-100
County Yamhill
Application No. GR-3815

Well Log

Owner: John McKinley Shaver Tex Bulb Farm Owner's No.

Driller: Steinman Brothers Drilling Company Date Drilled 4/20/53

[illegible]