

STATE ENGINEER
Salem, Oregon

Yamhill
2877

Well Record

STATE WELL NO. 3/2W-15A
COUNTY Yamhill
APPLICATION NO. CR-3784

OWNER: W.M. & Margaret S. Hays

MAILING

ADDRESS: Route 2, Box 312

LOCATION OF WELL: Owner's No. _____


CITY AND

STATE: Newberg, Oregon

NE 1/4 NE 1/4 Sec. 15 T. 3 N. S. R. 2 W., W.M.

Bearing and distance from section or subdivision

corner 752' W. & 251' S. of SE Cor. Sec. 10

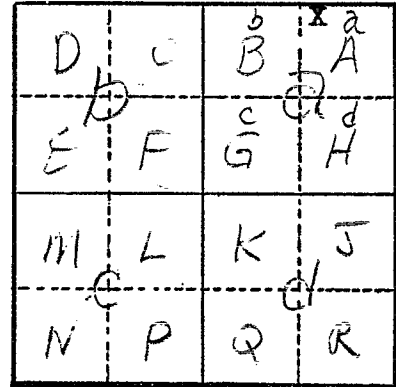

Section 15

Altitude at well _____

TYPE OF WELL: Drilled Date Constructed June, 1920

Depth drilled 208 feet Depth cased 60 feet

CASING RECORD:

6 inch casing set to 60 feet

FINISH:

AQUIFERS:

WATER LEVEL:

32 feet below surface

PUMPING EQUIPMENT: Type Jacuzzi H.P. 3

Capacity 13 1/2 G.P.M.

WELL TESTS:

Drawdown 6 ft. after _____ hours 16 2/3 G.P.M.

Drawdown _____ ft. after _____ hours _____ G.P.M.

USE OF WATER Irrigation Temp. _____ °F., 19 _____

SOURCE OF INFORMATION Well Registration Statement

DRILLER or DIGGER Huffman Drilling Co.

ADDITIONAL DATA:

Log _____ Water Level Measurements _____ Chemical Analysis _____ Aquifer Test _____

REMARKS:

445