

STATE ENGINEER
Salem, Oregon

Yamh
2387

Well Record

STATE WELL NO. 3/2W-15K(1)
COUNTY Yamhill
APPLICATION NO. GR-866

OWNER: Rudolph Schood


MAILING ADDRESS: Rt. 2, Box 320

LOCATION OF WELL: Owner's No. _____

CITY AND STATE: Newberg

NW ¼ SE ¼ Sec. 15 T. 3 ^{N.} S., R. 2 ^{E.} W., W.M.

Bearing and distance from section or subdivision
corner 600' S. & 250' E. of center of Sec. 15

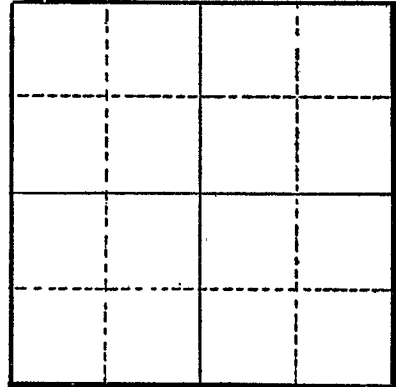

Section 15

Altitude at well 325'

TYPE OF WELL: Drilled Date Constructed Aug. '42

Depth drilled 140 Depth cased 140

CASING RECORD:

6" steel 0 to 140'

FINISH:

20 perforations ¼" x 4" 100-140'

AQUIFERS:

WATER LEVEL:

60'

PUMPING EQUIPMENT: Type Crane No. 9 H.P. 2 Elec.
Capacity 15 G.P.M. Delco S. P.

WELL TESTS:

Drawdown 100 ft. after 1 hours 1200 GPH ~~XXXX~~
Drawdown _____ ft. after _____ hours _____ G.P.M.

USE OF WATER Irrigation nursery Temp. _____ °F. _____, 19_____

SOURCE OF INFORMATION

DRILLER or DIGGER Hoffman Drilling Co.

ADDITIONAL DATA:

Log NA Water Level Measurements _____ Chemical Analysis _____ Aquifer Test _____

REMARKS: